

STATE ENGINEER  
Salem, Oregon

~~LANE~~ **LANE 66878**  
**Well Record**  
~~19540~~

STATE WELL NO. 17/2W-19N  
COUNTY Lane  
APPLICATION NO. GR-4267

OWNER: Floyd T. Ellefson


MAILING ADDRESS: **LANE 66878**  
2524 North 31st Street

LOCATION OF WELL: Owner's No.

CITY AND STATE: Springfield, Oregon

SW 1/4 SW 1/4 Sec. 19 T. 17 N. S. R. 2 W., W.M.

Bearing and distance from section or subdivision corner  
1250 feet East and 700 feet North from SW Corner, Section 19

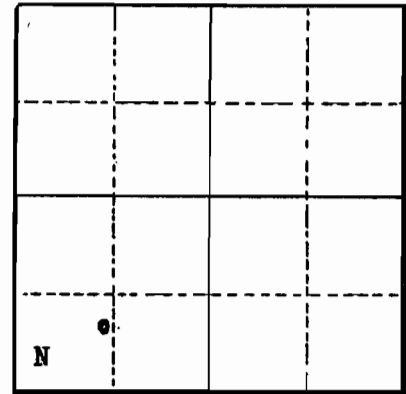

Altitude at well 150 feet

TYPE OF WELL: Driven Date Constructed Aug. 1, 1954

Depth drilled 20 feet Depth cased 17 feet

Section 19

CASING RECORD:

3-inch pipe casing set from 0 to 17 feet

FINISH:

yes, well point from 17 to 20 feet

AQUIFERS:

loam and gravel some sand

WATER LEVEL:

12 to 14 feet

PUMPING EQUIPMENT: Type Jacuzzi Centrifugal H.P.  
Capacity 25 G.P.M.

WELL TESTS:

Drawdown ? ft. after hours 213 G.P.M.

Drawdown ft. after hours G.P.M.

USE OF WATER Irrigation Temp. °F., 19

SOURCE OF INFORMATION GR-4118

DRILLER or DIGGER Meyer Well Service

ADDITIONAL DATA:

Log  Water Level Measurements Chemical Analysis Aquifer Test

REMARKS:

Loam and Gravel - some sand 20 feet