

STATE ENGINEER
Salem, Oregon

LANE 66879

~~LANE~~ Well Record

STATE WELL NO. 17/2W-19P
COUNTY Lane
APPLICATION NO. GR-748


OWNER: L. V. Gowdey

MAILING ADDRESS: LANE 66879

LOCATION OF WELL: Owner's No. CITY AND STATE: Springfield, Oregon

SE 1/4 SW 1/4 Sec. 19 T. 17 N. S, R. 2 W., W.M.

Bearing and distance from section or subdivision
corner S. 35° 33' E. 2788 ft. from NW cor. DLG 82
(Felix Scott)

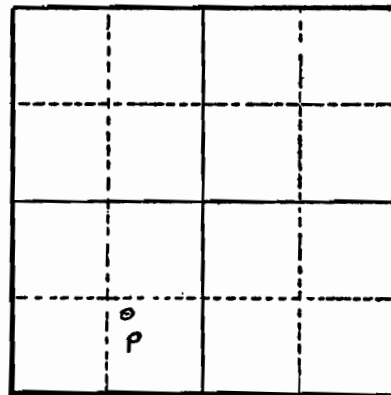

Section 19

Altitude at well

TYPE OF WELL: drilled Date Constructed 1955

Depth drilled 48 Depth cased 48

CASING RECORD: 5 inch

FINISH: Perforations from 12 to 48 ft.

AQUIFERS:

WATER LEVEL: 12 ft.

PUMPING EQUIPMENT: Type Berkeley centrifugal H.P. 2
Capacity 40 G.P.M.

WELL TESTS:
Drawdown 12 ft. after hours pumping 60 G.P.M.
Drawdown ft. after hours G.P.M.

USE OF WATER irrigation Temp. °F. 19

SOURCE OF INFORMATION GR-748, Cert. GR-812

DRILLER or DIGGER

ADDITIONAL DATA:

Log X Water Level Measurements Chemical Analysis Aquifer Test

REMARKS:

