

STATE ENGINEER
Salem, Oregon

LANE
6729

Well Record

STATE WELL NO. 15/5W-33J(1)
COUNTY Lane
APPLICATION NO. GR-423

OWNER: James J. Nielsen

MAILING
ADDRESS:

LOCATION OF WELL: Owner's No.


CITY AND
STATE:

Junction City, Oregon

NE $\frac{1}{4}$ SE $\frac{1}{4}$ Sec. 33 T. 15 S., R. 5 W., W.M.

Bearing and distance from section or subdivision

corner N. 33 chs. & 300 ft. W. of SE cor. Sec. 33

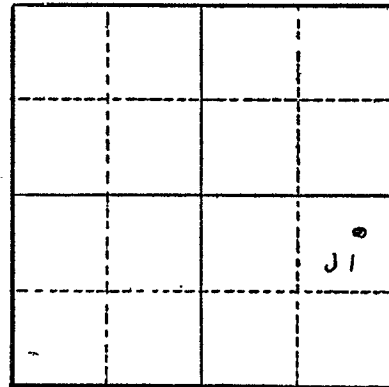

Altitude at well 309

TYPE OF WELL: driven Date Constructed Sept. 1953

Depth drilled 31 Depth cased

Section 33

CASING RECORD: 2 inch

FINISH:

AQUIFERS:

WATER LEVEL: 12

PUMPING EQUIPMENT: Type H.P. 2
Capacity 60 G.P.M.

WELL TESTS:

Drawdown ft. after hours G.P.M.

Drawdown ft. after hours G.P.M.

USE OF WATER irrigation 3 acres Temp. °F., 19

SOURCE OF INFORMATION GR-423

DRILLER or DIGGER owner

ADDITIONAL DATA:

Log No Water Level Measurements Chemical Analysis Aquifer Test

REMARKS: