

STATE ENGINEER
Salem, Oregon

LANE 67319

Well Record

STATE WELL NO. 17/3W-10L(1)

COUNTY Lane

APPLICATION NO. GR-381

OWNER: Roy L. & Ruth Snyder

MAILING ADDRESS: Rt. 2, Box 289


LOCATION OF WELL: Owner's No.

CITY AND STATE: Eugene, Oregon

NE 1/4 SW 1/4 Sec. 10 T. 17 N. S., R. 3 E. W., W.M.

Bearing and distance from section or subdivision

corner 1341.7 ft. E. & 907.36 ft. S. from W. cor. Sec. 10

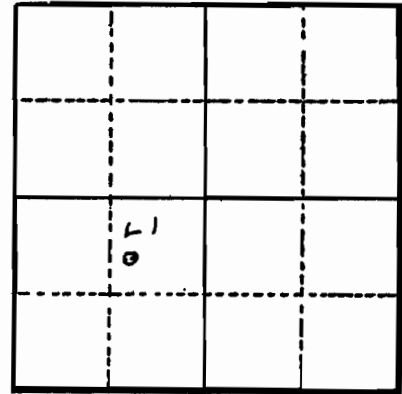

Section 10

Altitude at well approx. 430 ft.

TYPE OF WELL: driven Date Constructed 1950

Depth drilled 20 ft. Depth cased

CASING RECORD: 2 galvanized pipes driven, 2" dia. approx 5 ft. apart, 20 ft. deep

FINISH:

AQUIFERS:

WATER LEVEL: 8 ft.

PUMPING EQUIPMENT: Type Montgomery Ward H.P. 5
Capacity 150 G.P.M.

WELL TESTS:

Drawdown ft. after hours G.P.M.
Drawdown ft. after hours G.P.M.

USE OF WATER irrigation 10 acres Temp. °F. 19

SOURCE OF INFORMATION GR-381

DRILLER or DIGGER D. D. Dickenson

ADDITIONAL DATA:

Log No. Water Level Measurements Chemical Analysis Aquifer Test

REMARKS: