RECEIVED
JAN 5 1959
STATE ENGINEER
SALEM, OREGON

LANE 6761

File Original and First Copy with the STATE ENGINEER, SALEM, OREGON

WATER WELL REPORT
STATE OF OREGON

State Well No. 15/6W-25J

State Permit No.

(1) OWNER:
Name Elmer H. Emerson
Address Route 3 Box 329
Junction City Ore.

(2) LOCATION OF WELL:
County Lane Owner's number, if any—
¼ ¼ Section T. R. W.M.
Bearing and distance from section or subdivision corner
1/10 mi West of Turnbow Lane
150' South of Jacy Lane

(3) TYPE OF WORK (check):
New Well ☒ Deepening ☐ Reconditioning ☐ Abandon ☐
If abandonment, describe material and procedure in Item 11.

(4) PROPOSED USE (check):
Domestic ☐ Industrial ☐ Municipal ☐
Irrigation ☐ Test Well ☐ Other ☐

(5) TYPE OF WELL:
Rotary ☐ Driven ☐
Cable ☒ Jetted ☐
Dug ☐ Bored ☐

(6) CASING INSTALLED: Threaded ☐ Welded ☒
6" Diam. from 0 ft. to 65 ft. Gage 3/16" Wall
" Diam. from ft. to ft. Gage
" Diam. from ft. to ft. Gage

(7) PERFORATIONS: Perforated? ☐ Yes ☒ No
Type of perforator used
SIZE of perforations in. by in.
perforations from ft. to ft.
perforations from ft. to ft.
perforations from ft. to ft.
perforations from ft. to ft.
perforations from ft. to ft.

(8) SCREENS: Well screen installed ☐ Yes ☒ No
Manufacturer's Name
Type Model No.
Diam. Slot size Set from ft. to ft.
Diam. Slot size Set from ft. to ft.

(9) CONSTRUCTION:
Was well gravel packed? ☐ Yes ☒ No Size of gravel:
Gravel placed from ft. to ft.
Was a surface seal provided? ☒ Yes ☐ No To what depth? 65 ft.
Material used in seal— Casing
Did any strata contain unusable water? ☐ Yes ☒ No
Type of water? Depth of strata
Method of sealing strata off

(10) WATER LEVELS:
Static level 30 ft. below land surface Date 11-18
Artesian pressure lbs. per square inch Date

Log Accepted by:
[Signed] E. H. Emerson (Owner) Date 12-1, 1958

(11) WELL TESTS: Drawdown is amount water level is lowered below static level
Was a pump test made? ☐ Yes ☒ No If yes, by whom? -
Yield: gal./min. with ft. drawdown after hrs.
" " " "
" " " "
Bailer test 15 gal./min. with 30 ft. drawdown after 2 hrs.
Artesian flow g.p.m. Date
Temperature of water 54 Was a chemical analysis made? ☐ Yes ☒ No

(12) WELL LOG: Diameter of well 6 inches.
Depth drilled 96 ft. Depth of completed well 96 ft.
Formation: *Describe by color, character, size of material and structure, and show thickness of aquifers and the kind and nature of the material in each stratum penetrated, with at least one entry for each change of formation.*

MATERIAL	FROM	TO
Soft Yellow Sandy Clay	0	60
Drilled Thro Log	60	64
Hard Grey Rock	64	66
Soft " "	66	96
That's Right! Couldn't Find An Honest Well Driller So Had To Drill My Own!		

Work started 11-11 1958 Completed 11-18 1958

(13) PUMP:
Manufacturer's Name Homart
Type: ½ hp Jet H.P.

Well Driller's Statement:
This well was drilled under my jurisdiction and this report is true to the best of my knowledge and belief.
NAME Northwest Equipt Drilling Co. (Person, firm, or corporation) (Type or print)
Address Rt. 3 Box 329 Junction City
Driller's well number
[Signed] Elmer H. Emerson (Well Driller)
License No. 130 Date 12-1, 19

(USE ADDITIONAL SHEETS IF NECESSARY)

Beginning at a point on the south line of County survey No 1089 said point being 1320.0 feet South and 1320.0 feet West of the one quarter section corner on the east line of Section 25 in Township 15 South, Range 6 West of W. M.

The well is located 437.0 feet East and 831.0 North of this point of beginning.

The County road through the place is No 985

Hope this fixes this one up.
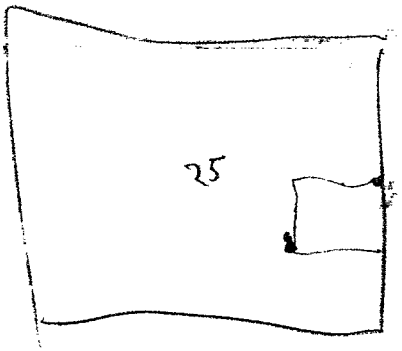
E. R. Emerson
Northwest Equip & Drilling Co.