

STATE ENGINEER
Salem, Oregon

LANE
6763

Well Record

STATE WELL NO. 15/6^w-25K
COUNTY Lane
APPLICATION NO. GR-2558

OWNER: E. R. Neil

MAILING

ADDRESS: Rt. 3, Box 331

LOCATION OF WELL: Owner's No.

CITY AND

STATE: Junction City, Oregon

NW 1/4 SE 1/4 Sec. 25 T. 15 S. R. 6 W., W.M.

Bearing and distance from section or subdivision


corner

Altitude at well 350'

TYPE OF WELL: Drilled Date Constructed 4-1-53

Depth drilled 92' Depth cased

CASING RECORD:

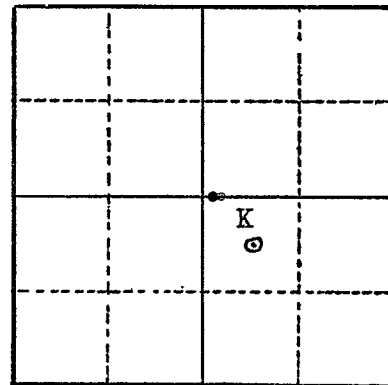

Section 25

FINISH:

AQUIFERS:

WATER LEVEL:

20'

PUMPING EQUIPMENT: Type Worthington H.P. 5
Capacity G.P.M.

WELL TESTS:

Drawdown ft. after hours G.P.M.

Drawdown ft. after hours G.P.M.

USE OF WATER Irrigation Temp. °F., 19

SOURCE OF INFORMATION GR-3988

DRILLER or DIGGER

ADDITIONAL DATA:

^ Wayne Hayes, Eugene, Oregon ^

Log NA Water Level Measurements Chemical Analysis Aquifer Test

REMARKS: