

STATE OF OREGON
WATER SUPPLY WELL REPORT
(as required by ORS 537.765 & OAR 690-205-0210)

12-28-2009

WELL LABEL # L 102334
START CARD # 1009147

(1) LAND OWNER Owner Well I.D. _____
First Name _____ Last Name _____
Company WILLAMALANE PARK AND RECREATION DISTRICT
Address 250 S. 32nd
City Springfield State OR Zip 97478

(2) TYPE OF WORK New Well Deepening Conversion
 Alteration (repair/recondition) Abandonment

(3) DRILL METHOD
 Rotary Air Rotary Mud Cable Auger Cable Mud
 Reverse Rotary Other _____

(4) PROPOSED USE Domestic Irrigation Community
 Industrial/ Commercial Livestock Dewatering
 Thermal Injection Other _____

(5) BORE HOLE CONSTRUCTION Special Standard Attach copy
Depth of Completed Well 39.00 ft.

BORE HOLE			SEAL			sacks/ lbs	
Dia	From	To	Material	From	To	Amt	
10	0	18	Bentonite	0	2	2	S
6	18	39	Cement	2	18	16	S

How was seal placed: Method A B C D E
 Other POURED AND TAMPED
Backfill placed from _____ ft. to _____ ft. Material _____
Filter pack from _____ ft. to _____ ft. Material _____ Size _____
Explosives used: Yes Type _____ Amount _____

(6) CASING/LINER

Casing	Liner	Dia	+	From	To	Gauge	Stl	Plstc	Wld	Thrd
<input checked="" type="checkbox"/>	<input type="checkbox"/>	6	<input checked="" type="checkbox"/>	2	38	.25	<input checked="" type="checkbox"/>	<input type="checkbox"/>	<input checked="" type="checkbox"/>	<input type="checkbox"/>

Shoe Inside Outside Other Location of shoe(s) 38
Temp casing Yes Dia _____ From _____ To _____

(7) PERFORATIONS/SCREENS

Perforations Method HOLT AIR PERFORATOR
Screens Type _____ Material _____

Perf/Screen	Casing/Liner	Dia	From	To	Sern/slot width	Slot length	# of slots	Tele/pipe size
Perf	Casing	6	20	38	25	1	200	

(8) WELL TESTS: Minimum testing time is 1 hour

Pump Bailer Air Flowing Artesian

Yield gal/min	Drawdown	Drill stem/Pump depth	Duration (hr)
10		39	1

Temperature 57 °F Lab analysis Yes By _____
Water quality concerns? Yes (describe below)
From _____ To _____ Description _____

(9) LOCATION OF WELL (legal description)
County Lane Twp 18.00 S N/S Range 2.00 W E/W WM
Sec 8 NW 1/4 of the NE 1/4 Tax Lot 300
Tax Map Number _____ Lot _____
Lat _____ " or _____ DMS or DD
Long _____ " or _____ DMS or DD
 Street address of well Nearest address
CLEARWATER PARK OFF CLEARWATER LANE, SPRINGFIELD,OR

(10) STATIC WATER LEVEL

Existing Well / Predeepening	Date	SWL(psi)	+	SWL(ft)
Completed Well	12-23-2009			12

Flowing Artesian? Dry Hole?

WATER BEARING ZONES Depth water was first found 18

SWL Date	From	To	Est Flow	SWL(psi)	+	SWL(ft)
12-23-2009	18	37	10			12

(11) WELL LOG

Material	From	To
TOP SOIL	0	1
GRAVEL WITH BROWN SAND	1	37
BLUE SANDSTONE	37	39

Ground Elevation _____

IMPORTANT DOCUMENT!
Please save with your property records for future reference.


Date Started 12-22-2009 Completed 12-23-2009

(unbonded) Water Well Constructor Certification
I certify that the work I performed on the construction, deepening, alteration, or abandonment of this well is in compliance with Oregon water supply well construction standards. Materials used and information reported above are true to the best of my knowledge and belief.

License Number 1776 Date 12-28-2009
Electronically Filed
Signed DOUGLAS D TUCKER (E-filed)


(bonded) Water Well Constructor Certification
I accept responsibility for the construction, deepening, alteration, or abandonment work performed on this well during the construction dates reported above. All work performed during this time is in compliance with Oregon water supply well construction standards. This report is true to the best of my knowledge and belief.

License Number 1541 Date 12-28-2009
Electronically Filed
Signed CASEY JONES JR (E-filed)
Contact Info (optional) Casey Jones Well Drilling Co., Inc. 541-747-2806

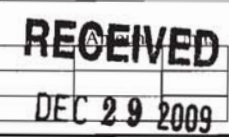

LANE 70264

EXEMPT USE WELL LOCATION MAP

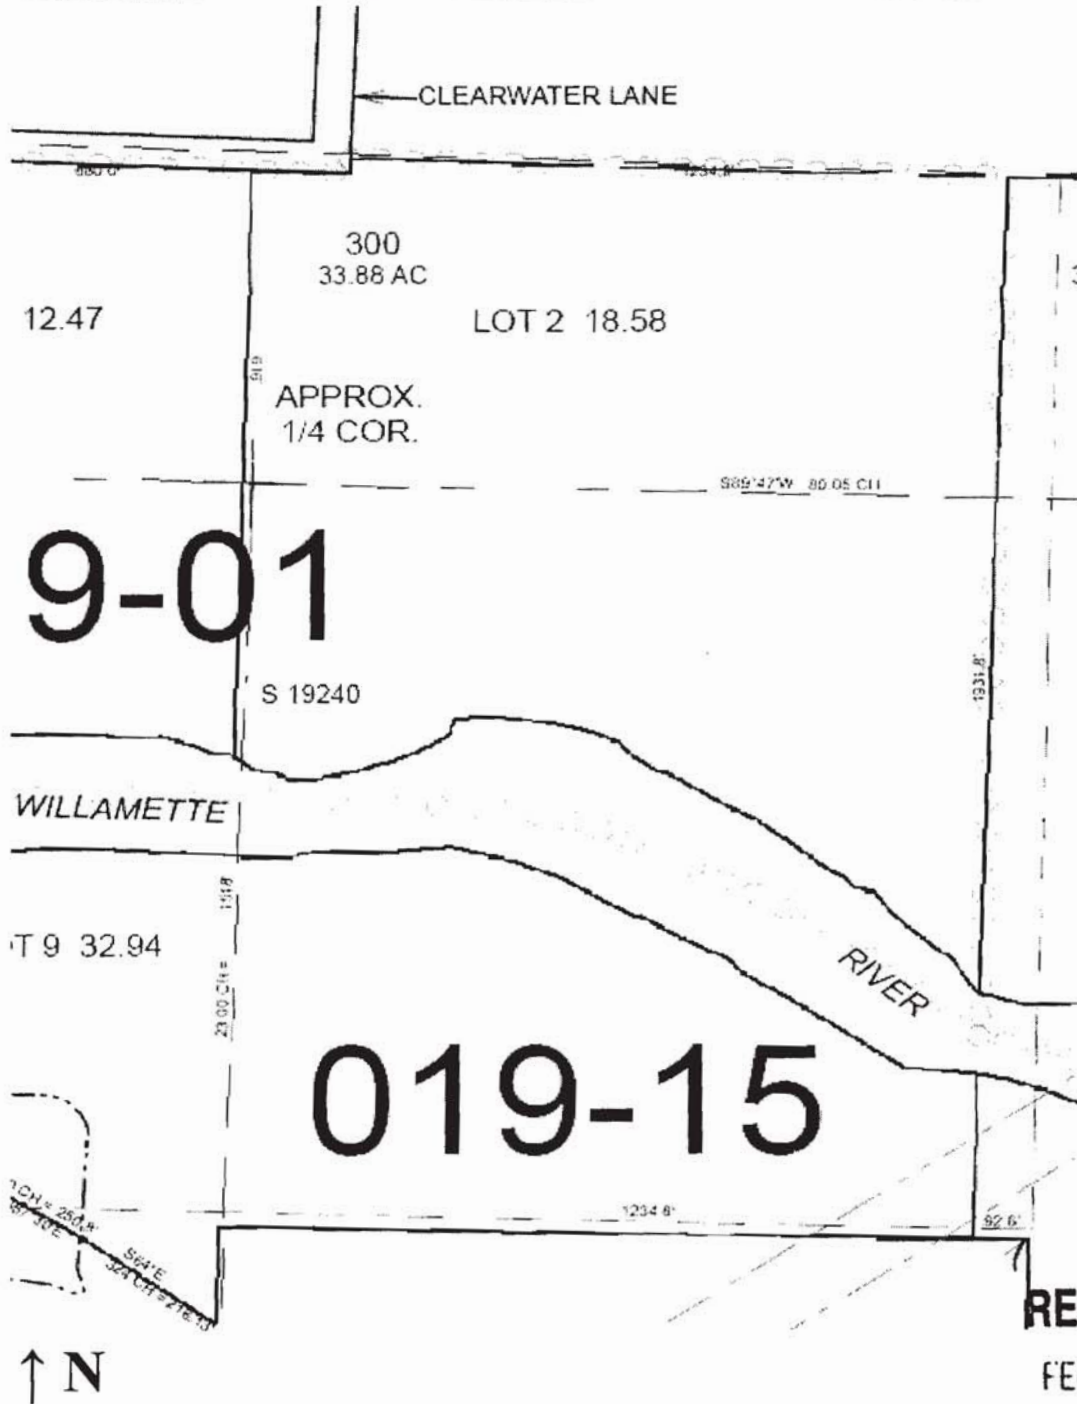

Lane County

Assessor Map Reference Number: **18S 2W 8 NWNE: Tax Lot 300**

Street Address of Well, if Available: **Clearwater Park off Clearwater Lane,**

Springfield, OR. Well Log # **LANE 70264**, Well Label (ID Tag) # **L 102334**. (Please Locate Well and Indicate distance From Property or Survey Corner, See Attached Sample Well Location Map.) **MAP NOT TO SCALE**

RECEIVED
FEB 01 2010
WATER RESOURCES DEPT
SALEM, OREGON