

Lane 70495

MAY 27 2010

STATE OF OREGON WATER SUPPLY WELL REPORT (as required by ORS 537.765)

WATER RESOURCES DEPT SALEM, OREGON

WELL I.D. # L 76770 START CARD # W 205112

Instructions for completing this report are on the last page of this form.

(1) LAND OWNER Well Number Name City of Junction City

Address P.O. Box 250 City Junction City State OR Zip 97448

(2) TYPE OF WORK New Well Deepening Alteration (repair/recondition) Abandonment

(3) DRILL METHOD: Rotary Air Rotary Mud Cable Auger Other

(4) PROPOSED USE: Domestic Community Industrial Irrigation Thermal Injection Livestock Other

(5) BORE HOLE CONSTRUCTION: Special Construction approval Yes No Depth of Completed Well 267.5' Explosives used Yes No Type Amount

Table with columns: HOLE Diameter, From, To, Material, SEAL From, To, Sacks or pounds. Includes entries for Cement and Quick Grout.

How was seal placed: Method A B C D E Other Pressure grouted thru trimmie pipe Backfill placed from ft. to ft. Material Gravel placed from ft. to ft. Size of gravel

(6) CASING/LINER: Diameter From To Gauge Steel Plastic Welded Threaded Casing: 16" +2 142.5 Liner: 10" 132.5 135 10" 183 224.5 10" 263.5 267.5

(7) PERFORATIONS/SCREENS: Perforations Method Screens Type Alloy Material Stainless Steel From To Slot size Number Diameter Tele/pipe size Casing Liner

(8) WELL TESTS: Minimum testing time is 1 hour Pump Bailer Air Flowing Artesian Yield gal/min Drawdown Drill stem at Time 1102 94'3" 48 Hrs.

Temperature of water 55.2° Depth Artesian Flow Found Was a water analysis done? Yes By whom Owner Did any strata contain water not suitable for... Salty Muddy Odor Colored Other Depth of strata:

(9) LOCATION OF WELL by legal description: County Lane Latitude Longitude Township 15 S N or S Range 4 W E or W. WM. Section 32 SE 1/4 NW 1/4 Tax Lot R.O.W. Lot Block Subdivision Street Address of Well (or nearest address) 11th & Elm St. Junction City, OR

(10) STATIC WATER LEVEL: 15 ft. below land surface. Date 5-18-10 Artesian pressure lb. per square inch Date

(11) WATER BEARING ZONES: Depth at which water was first found 18' Table with columns: From, To, Estimated Flow Rate, SWL. Includes data for 18-35, 36-40, 80-102, 138-158, 170-185.

(12) WELL LOG: Continued on page # 2 Ground Elevation

Table with columns: Material, From, To, SWL. Lists various soil layers like Fill, Brown clay gravel, Brown clay, etc.

Date started 2-9-10 Completed 5-20-10

(unbonded) Water Well Constructor Certification: I certify that the work I performed on the construction, alteration, or abandonment of this well is in compliance with Oregon water supply well construction standards. Terry Johnson WWC Number 1321 Signed Date 5-24-10

(bonded) Water Well Constructor Certification: I accept responsibility for the construction, alteration, or abandonment work performed on this well during the construction dates reported above. Ron Aspaas WWC Number 1445 Signed Date 5-24-10

Lane 70495

STATE OF OREGON WATER SUPPLY WELL REPORT (as required by ORS 537.765)

WELL I.D. # L 76770 START CARD # W 205112

Instructions for completing this report are on the last page of this form.

(1) LAND OWNER Name City of Junction City Address P.O. Box 250 City Junction City State OR Zip 97448

(2) TYPE OF WORK [X] New Well [] Deepening [] Alteration (repair/recondition) [] Abandonment

(3) DRILL METHOD: [] Rotary Air [] Rotary Mud [X] Cable [] Auger [] Other

(4) PROPOSED USE: [] Domestic [X] Community [] Industrial [] Irrigation [] Thermal [] Injection [] Livestock [] Other

(5) BORE HOLE CONSTRUCTION: Special Construction approval [] Yes [X] No Depth of Completed Well 267.5' Explosives used [] Yes [X] No Type Amount

Table with columns: HOLE Diameter, From, To, SEAL Material, From, To, Sacks or pounds

How was seal placed: Method [] A [] B [] C [] D [] E [] Other

Backfill placed from ft. to ft. Material Gravel placed from ft. to ft. Size of gravel

(6) CASING/LINER: Table with columns: Diameter, From, To, Gauge, Steel, Plastic, Welded, Threaded

(7) PERFORATIONS/SCREENS: [] Perforations Method [] Screens Type Material

Table with columns: From, To, Slot size, Number, Diameter, Tele/pipe size, Casing, Liner

(8) WELL TESTS: Minimum testing time is 1 hour [] Pump [] Bailer [] Air [] Flowing Artesian

Temperature of water Depth Artesian Flowing Was a water analysis done? [] Yes By whom

Did any strata contain water not suitable for intended use? [] Salty [] Muddy [] Odor [] Colored [] Other

Depth of strata: WATER RESOURCES DEPT SALEM, OREGON

(9) LOCATION OF WELL by legal description: County Lane Latitude Longitude Township 15 S N or S Range 4 W E or W. WM. Section 32 SE 1/4 NW 1/4 Tax Lot R.O.W. Lot Block Subdivision Street Address of Well (or nearest address) 11th & Elm St. Junction City, OR

(10) STATIC WATER LEVEL: 15 ft. below land surface. Date 5-18-10 Artesian pressure lb. per square inch Date

(11) WATER BEARING ZONES: Depth at which water was first found 18'

Table with columns: From, To, Estimated Flow Rate, SWL

(12) WELL LOG: Continued from page # 1 Ground Elevation

Table with columns: Material, From, To, SWL

RECEIVED

MAY 27 2010


WATER RESOURCES DEPT SALEM, OREGON

Date started 2-9-10 Completed 5-20-10

(unbonded) Water Well Constructor Certification: I certify that the work I performed on the construction, alteration, or abandonment of this well is in compliance with Oregon water supply well construction standards. Materials used and information reported above are true to the best of my knowledge and belief. Terry Johnson Signed Terry Johnson WWC Number 1321 Date 5-24-10

(bonded) Water Well Constructor Certification: I accept responsibility for the construction, alteration, or abandonment work performed on this well during the construction dates reported above. All work performed during this time is in compliance with Oregon water supply well construction standards. This report is true to the best of my knowledge and belief. Roy Aspaas Signed Roy Aspaas WWC Number 1445 Date 5-24-10

Lane
70495

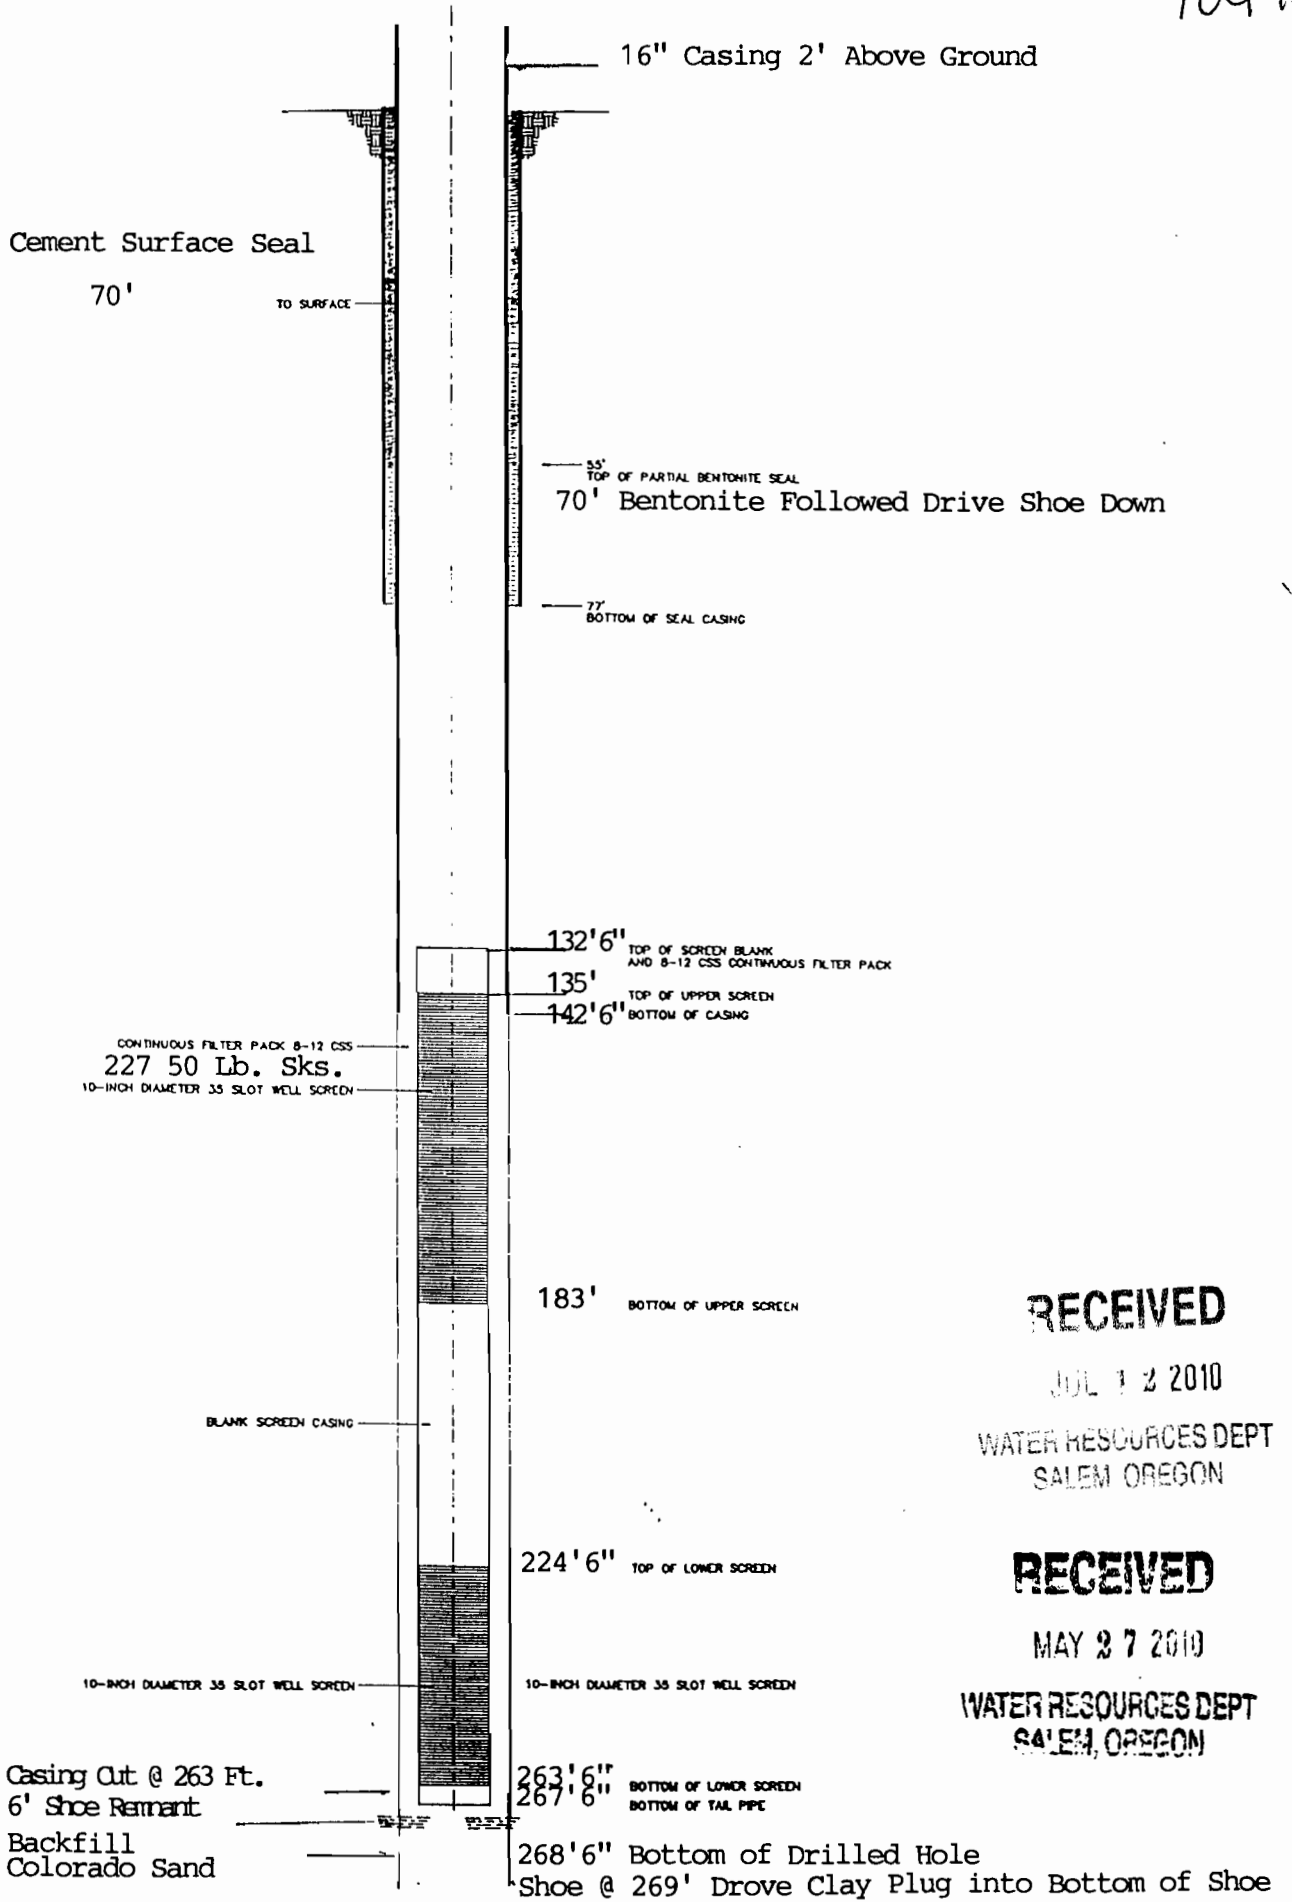

RECEIVED

JUL 12 2010
WATER RESOURCES DEPT
SALEM OREGON

RECEIVED

MAY 27 2010
WATER RESOURCES DEPT
SALEM OREGON