


Lane
70504

WELL I.D. # L 60240
START CARD # W201044

ORIGINAL – WATER RESOURCES DEPARTMENT FIRST COPY – CONSTRUCTOR SECOND COPY – CUSTOMER

EXEMPT USE WELL LOCATION MAP

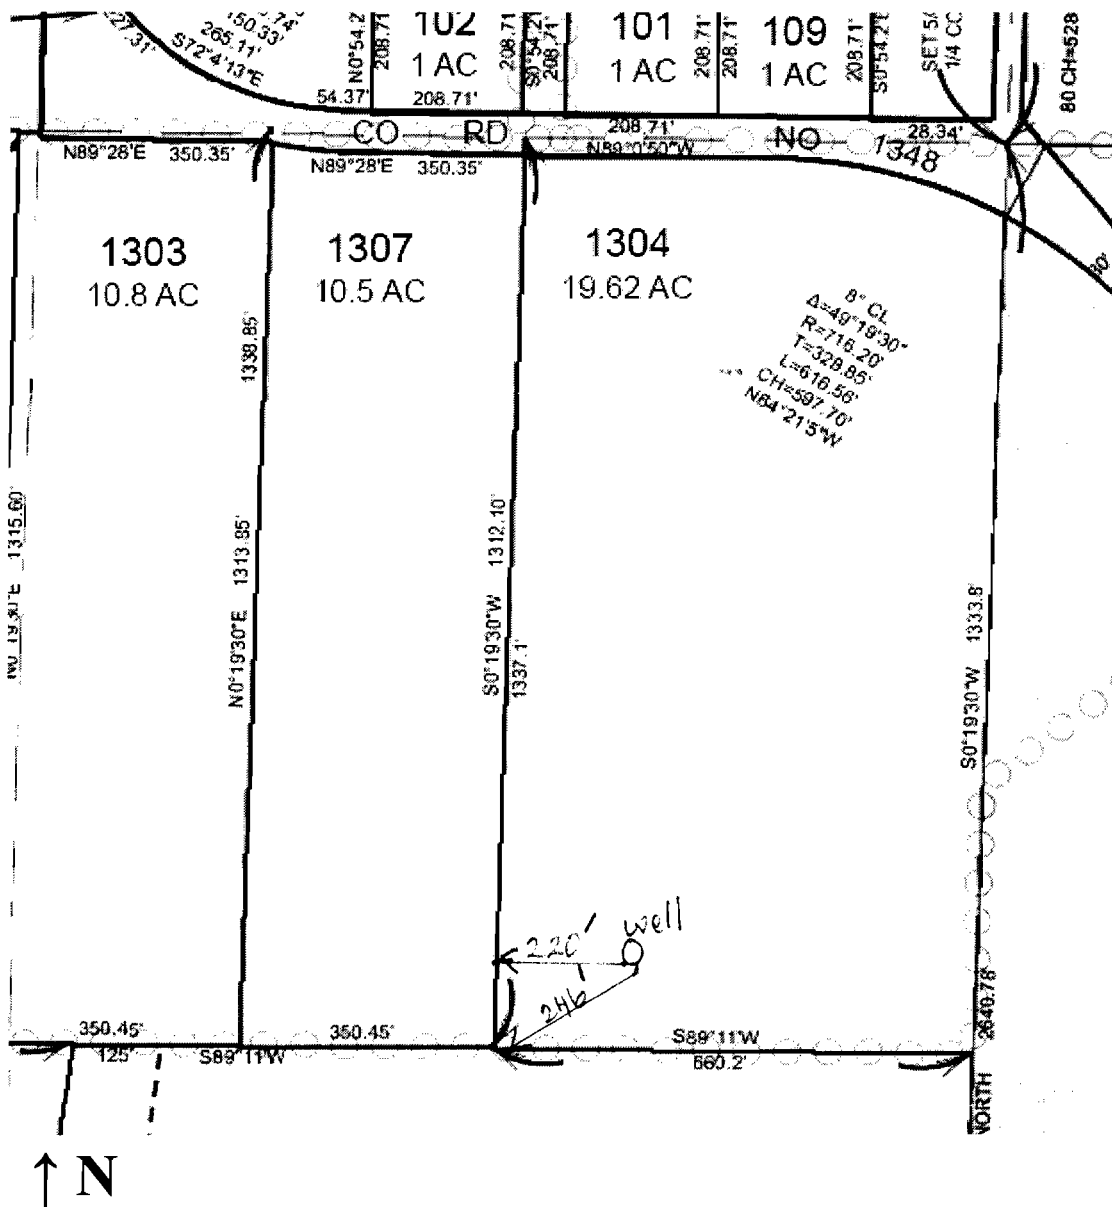

Lane County

Assessor Map Reference Number: 16 S 2W 14 SWNE: Tax Lot 1304.

Street Address of Well, if Available: Next To 37408 Parsons Creek Road, Springfield, OR. Well Log #. LANE 70504. Well Label (ID Tag) # L 60240. (Please Locate Well and Indicate distance From Property or Survey Corner, See Attached Map.) You may also locate your well using our exempt use well mapping tool on our website at www.wrd.state.or.us/OWRD/exempt_use_788_info.shtml or by contacting the Exempt Use Well Program Coordinator at 503 986-0861.

MAP NOT TO SCALE

RECEIVED

JUN 16 2011

WATER RESOURCES DEPT
SALEM, OREGON
LAND OWNER SUBMITTED MAP