

STATE OF OREGON
WATER SUPPLY WELL REPORT

LANE 70681

WELL LABEL # L 102025
START CARD # 204575
ORIGINAL LOG #

(ORS 537.765 & OAR 690-205-0210)

Instructions for completing this report are on the last page of this form.

(1) LANDOWNER Owner Well I.D. 2781
First Name Ray Last Name Harper
Company _____
Address 92684 River Rd
City Junction City State OR Zip 97448

(2) TYPE OF WORK New Conversion Deepening
 Alteration (complete Sections 2a & 10) Abandonment (complete Section 5a)

(2a) PRE-ALTERATION: Well Depth _____ ft.
Seal Material _____
Casing Type: Steel Plastic Other _____
Casing Gauge _____ Casing Diameter _____

(3) DRILL METHOD Rotary Air Rotary Mud Auger
 Cable Cable Mud Reverse Rotary Other _____

(4) PROPOSED USE Domestic Irrigation Community
 Industrial/Commercial Livestock Dewatering Injection
 Thermal Other _____

(5) BORE HOLE CONSTRUCTION
Depth of Completed Well 39' ft. Special Standard: Yes (attach copy)

BORE HOLE			SEAL				
Dia	From	To	Material	From	To	Amount	Scks/lbs
10"	0'	19'	Bentonite	0'	19'	8	scks
6"	19'	39'					

How was seal placed: Method A B C D E
 Other Bentonite Placed @ 1 sck per 5 min rate
Backfill placed from _____ ft. to _____ ft. Material _____
Filter pack from _____ ft. to _____ ft. Material _____ Size _____

(5a) ABANDONMENT USING UNHYDRATED BENTONITE:
Calculated Amount Proposed to be Used: _____ sacks/lbs
Actual Amount Used: _____ sacks/lbs

(6) CASING/LINER

Csng	Lnr	Dia	+	From	To	Gauge	Steel	Plastic	Welded	Thrd
X		6"		1'	39'	.250	X		X	

Shoe Inside Outside Other Location of shoe(s) None
Temporary casing Yes Diameter _____ From _____ To _____

(7) PERFORATIONS/SCREENS
Perforations Method Air Perforator
Screens Type _____ Material _____

Perf	Scrn	Csng	Lnr	Screen Dia	From	To	Screen/slot width	Slot length	# of slots	Tele/pipe size
X	X				31'	35'	5"	1"	120	

(8) WELL TESTS: Minimum testing time is 1 hour
 Pump Bailer Air Flowing Artesian
Yield gal/min 25gpm Drawdown _____ Drill stem/Pump depth 39' Duration (hr) 1 hr
Temperature 57°F Lab analysis Yes By _____
Water quality concerns? Yes (describe below) TDS _____ ppm

From	To	Description	Amount	Units

(9) LOCATION OF WELL (legal description)
County lane Twp 16S N of S Range 04W E of W.W.M.
Sec 9 SE 1/4 of the SE 1/4 Tax Lot 2200
Tax Map Number _____ Lot _____
Lat _____ " or _____ DMS or DD
Long _____ " or _____ DMS or DD

Street Address of Well (or nearest address) 30020 Harper Rd
Junction City, OR 97448

(10) STATIC WATER LEVEL

	Date	SWL (psi)	+	SWL (ft)
Existing Well/Pre-Alteration				
Completed Well	<u>8-9-10</u>			<u>12'</u>

Flowing Artesian? Yes Dry Hole? Yes

WATER BEARING ZONES Depth water was first found 25'

SWL Date	From	To	Est Flow	SWL (psi)	+	SWL (ft)
<u>8-9-10</u>	<u>25'</u>	<u>39'</u>	<u>25gpm</u>			<u>12'</u>

(11) WELL LOG Ground Elevation _____

Material	From	To
<u>Topsoil</u>		<u>0 2</u>
<u>Brown Sandy loam</u>	<u>2</u>	<u>13</u>
<u>Brown clay w/ gravel</u>	<u>13</u>	<u>19</u>
<u>Gravel & sand</u>	<u>19</u>	<u>39</u>


Date Started 8-9-10 Completed 8-9-10

(unbonded) Water Well Constructor Certification
I certify that the work I performed on the construction, deepening, alteration, or abandonment of this well is in compliance with Oregon water supply well construction standards. Materials used and information reported above are true to the best of my knowledge and belief.

License Number _____ Date _____
Signed _____

(bonded) Water Well Constructor Certification
I accept responsibility for the construction, deepening, alteration, or abandonment work performed on this well during the construction dates reported above. All work performed during this time is in compliance with Oregon water supply well construction standards. This report is true to the best of my knowledge and belief.

License Number 751 Date 8-9-10
Signed Donald J. Foving
Contact Info. (optional)
Mid Valley Drilling Inc
Joe having 541-847-5470

 


70681
Ray W & Geraldine Harper
92684 River Rd
Junction City, OR 97448-9409

INV# Receipt#
1501040

SC# 204575

92950 River Road

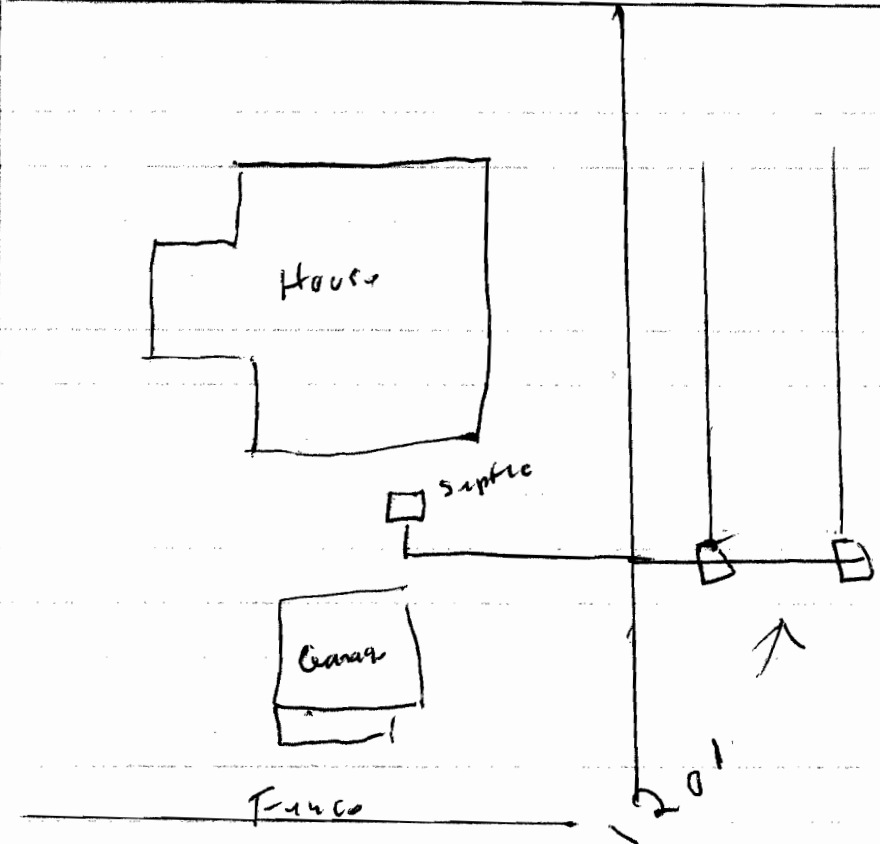

RECEIVED

AUG 25 2010

NATURAL RESOURCES DEPT
GALATIEN DIVISION

N

Harper Road

← 25' → Well
to utility line

Property class 551
tax code area 06928 9.72 acres
Tax lot 16-04-09-00-02200

30020 Harper Rd
Junction City 97448

GPS location of well
44-11-184
123-10-196

LAND OWNER SUBMITTED MAP