

STATE ENGINEER
Salem, Oregon

LANE
7139

Well Record


STATE WELL NO. 16/2W-24M
COUNTY Lane
APPLICATION NO. GR-4199

OWNER: Richard O. & Emily J. Eymann MAILING ADDRESS: Star Route

LOCATION OF WELL: Owner's No. CITY AND STATE: Mohawk, Oregon

NW 1/4 SW 1/4 Sec. 24 T. 16 S., R. 2 W., W.M.

Bearing and distance from section or subdivision corner 2075' N. & 900' E. from SW Cor.

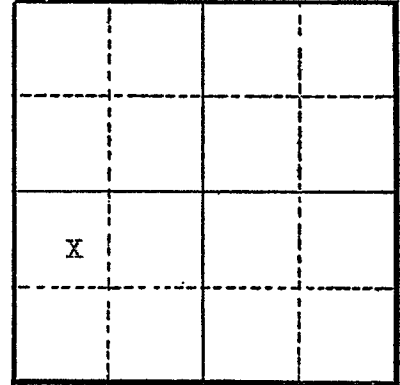

Section 24

Altitude at well

TYPE OF WELL: Drilled Date Constructed 7/35

Depth drilled 50 to 100 ft. Depth cased

CASING RECORD:

FINISH:

AQUIFERS:

WATER LEVEL:

50 to 100 feet below surface

PUMPING EQUIPMENT: Type Berkeley jet H.P. 1/2
Capacity 6.0 G.P.M.

WELL TESTS:

Drawdown ft. after hours G.P.M.
Drawdown ft. after hours G.P.M.

USE OF WATER Irrigation Temp. °F., 19

SOURCE OF INFORMATION Well Registration Statement Cert. # GR-3752

DRILLER or DIGGER Farm Resettlement Administration

ADDITIONAL DATA:

Log Water Level Measurements Chemical Analysis Aquifer Test

REMARKS: