

STATE ENGINEER
Salem, Oregon


LANE
73738

LANE 73738
Well Record

STATE WELL NO. 16/3-18F
COUNTY Lane
~~APPLICATION NO.~~ GR-3561

OWNER: C. A. Barrows
MAILING ADDRESS: Rt. 2, Box 465
CITY AND STATE: Eugene, Oregon

LOCATION OF WELL: Owner's No.
SE 1/4 NW 1/4 Sec. 18 T. 16 S., R. 3 W., W.M.
Bearing and distance from section or subdivision
corner 2585' S. & 1480' E. of NW corner Sec 18

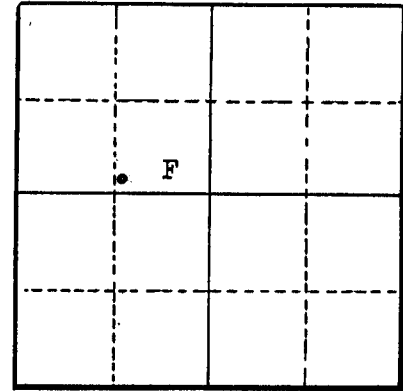

Altitude at well

TYPE OF WELL: Dug Date Constructed 9/52

Depth drilled 18' Depth cased

Section 18

CASING RECORD:

FINISH:

AQUIFERS:

Top soil, clay, sand & gravel

WATER LEVEL:

8'

PUMPING EQUIPMENT: Type Homemade box pump H.P. 15
Capacity 750 G.P.M.

WELL TESTS:

Drawdown ft. after hours G.P.M.
Drawdown ft. after hours G.P.M.

USE OF WATER Irrigation Temp. °F., 19

SOURCE OF INFORMATION GR-4002

DRILLER or DIGGER

ADDITIONAL DATA:

Log X Water Level Measurements Chemical Analysis Aquifer Test

REMARKS:

Top soil 0 to 2
Clay 2 to 5
Sand & Gravel 5 to 11