

LANE  
7398

# Well Record

GR- 1021

OWNER: Dwight Feulner

MAILING  
ADDRESS:


LOCATION OF WELL: Owner's No.

CITY AND  
STATE: Eugene, Oregon

SE 1/4 SW 1/4 Sec. 18 T. 16 S., R. 3 W., W.M.

Bearing and distance from section or subdivision

corner 2375' E.) from SW cor. of Sec. 18.  
& 750' N.)

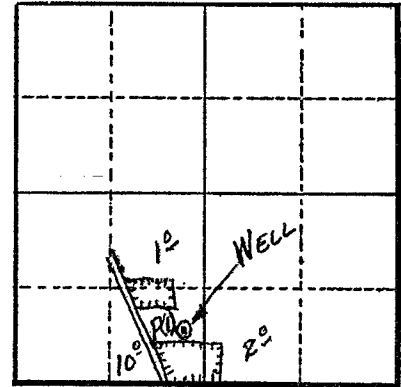

Section 18

Altitude at well 363 ft.

TYPE OF WELL: Drilled Date Constructed 1952

Depth drilled 40 ft. Depth cased 40 ft.

### CASING RECORD:

6 inch

### FINISH:

28 or 30 perforations from 10 to 40 ft.

### AQUIFERS:

### WATER LEVEL:

8 ft.

PUMPING EQUIPMENT: Type F. M.

H.P. 7 1/2

Capacity 175 G.P.M.

### WELL TESTS:

Drawdown 3 ft. after 160 hours G.P.M.

Drawdown ft. after hours G.P.M.

USE OF WATER Irrigation & Domestic Temp. °F., 19

SOURCE OF INFORMATION G.R. Record

DRILLER or DIGGER Wayne Hays

### ADDITIONAL DATA:

Log N.A. Water Level Measurements Chemical Analysis Aquifer Test

### REMARKS:

Irrigation of 13 acres.