

STATE ENGINEER
Salem, Oregon

LANE
7402

Well Record

GR- 1363

STATE WELL NO. 16/3W-19F
COUNTY Lane
APPLICATION NO. GR- 1408

OWNER: Charles E. & Lottie R. Vogel

MAILING ADDRESS: Rt. 2, Box 464


LOCATION OF WELL: Owner's No.

CITY AND STATE: Eugene, Oregon

SE 1/4 NW 1/4 Sec. 19 T. 16 S., R. 3 W., W.M.

Bearing and distance from section or subdivision

corner 2843.3' E. & 540' N. from W. cor. Sec. 19

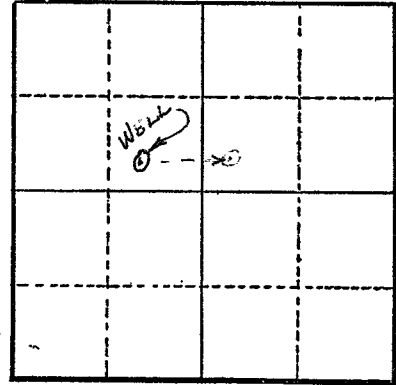

Section 19

Altitude at well 485 ft.

TYPE OF WELL: Drilled Date Constructed 1952

Depth drilled 47 ft. Depth cased 47 ft.

CASING RECORD:

6 inch

FINISH:

Perforated: 4 cuts, 2 ft. long from 10 to 27 ft.

AQUIFERS:

WATER LEVEL:

10 ft.

PUMPING EQUIPMENT: Type F. M. turbine H.P. 15
Capacity 250 G.P.M.

WELL TESTS:

Drawdown 16 ft. after 180 hours G.P.M.

Drawdown ft. after hours G.P.M.

USE OF WATER Irrigation Temp. °F., 19

SOURCE OF INFORMATION G. R. Record

DRILLER or DIGGER

ADDITIONAL DATA:

Log Water Level Measurements Chemical Analysis Aquifer Test

REMARKS:

Log: Black dirt 0 to 27 ft.
Coarse sand 27 to 47 ft.

Irrigation of 29 acres.