

LANE
7432

Well Record

OWNER: Joseph H. & Edna E. Hunt

MAILING ADDRESS: Rt 2 Box 411A

LOCATION OF WELL: Owner's No.


CITY AND STATE: Eugene

NW 1/4 SE 1/4 Sec. 29 T. 16 S., R. 3 W., W.M.

Bearing and distance from section or subdivision

corner 2475' S & 1462' W NE cor of M. Brown DLC #58

500' S & 2550' W from E 1/4 cor Sec 29

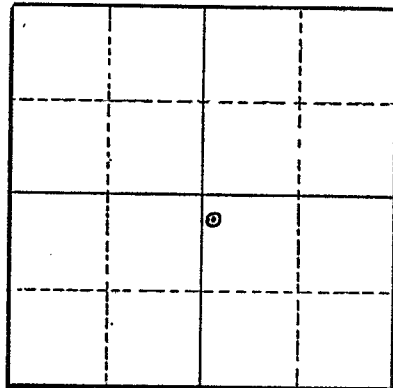

Section 29

Altitude at well

TYPE OF WELL: Drilled Date Constructed 1955

Depth drilled 37' Depth cased

CASING RECORD:

FINISH:

AQUIFERS:

WATER LEVEL:

8'

PUMPING EQUIPMENT: Type F. M.

Capacity 60 G.P.M.

H.P. 3

WELL TESTS:

Drawdown 20 ft. after hours 40 G.P.M.

Drawdown ft. after hours G.P.M.

USE OF WATER Irrigation

Temp. °F. 19

SOURCE OF INFORMATION GR-3983

DRILLER or DIGGER Elmer Haun

ADDITIONAL DATA:

Log NA Water Level Measurements Chemical Analysis Aquifer Test

REMARKS: