

LANE
7435

Well Record

OWNER: George F. McKibben

MAILING

ADDRESS: Rt. 2, Box 420


LOCATION OF WELL: Owner's No. _____

CITY AND

STATE: Eugene, Oregon

SW $\frac{1}{4}$ SE $\frac{1}{4}$ Sec. 29 T. 16 ^N S., R. 3 ^E W., W.M.

Bearing and distance from section or subdivision
corner N. 58° 30' W. 1046 ft. from SW cor. of Issac
Van Duyn DLC 61

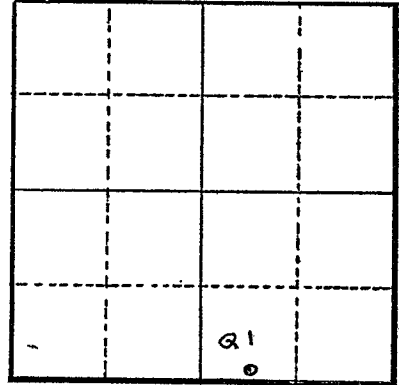

Section 29

Altitude at well 390

TYPE OF WELL: dug Date Constructed 8/3/50

Depth drilled 20 Depth cased _____

CASING RECORD:

FINISH:

AQUIFERS:

WATER LEVEL: ?

PUMPING EQUIPMENT: Type Fairbanks Morse centrifugal H.P. 10
Capacity 200 G.P.M.

WELL TESTS:

Drawdown _____ ft. after _____ hours _____ G.P.M.

Drawdown _____ ft. after _____ hours _____ G.P.M.

USE OF WATER irrigation 18 acres Temp. _____ °F., 19

SOURCE OF INFORMATION GR-444

DRILLER or DIGGER _____

ADDITIONAL DATA:

Log X Water Level Measurements _____ Chemical Analysis _____ Aquifer Test _____

REMARKS: Log: Sawmill waste 0 to 4 ft.
Sand & gravel 4 to 20 ft.