

LAKE
7458

Well Record

STATE WELL NO. 16/3W-29M
COUNTY Lane
APPLICATION NO. GR-3459

OWNER: James Lake


MAILING ADDRESS: Route 2, Box 402

LOCATION OF WELL: Owner's No. Well #1

CITY AND STATE: Eugene, Oregon

NW 1/4 SW 1/4 Sec. 29 T. 16 N. S., R. 3 E. W., W.M.

Bearing and distance from section or subdivision corner N. 1280' W. 381'

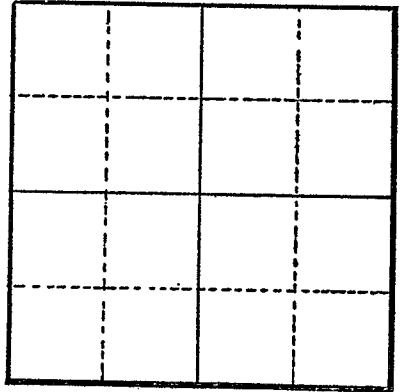

Section

Altitude at well

TYPE OF WELL: driven Date Constructed 1941

Depth drilled 24' Depth cased 24'

CASING RECORD:
6"

FINISH:

AQUIFERS:

WATER LEVEL:

12'

PUMPING EQUIPMENT: Type General Electric Cent. 4" x 2" H.P. 7 1/2
Capacity 240 G.P.M.

WELL TESTS:

Drawdown ft. after hours G.P.M.
Drawdown ft. after hours G.P.M.

USE OF WATER Irrigation Temp. °F., 19
SOURCE OF INFORMATION GR-3200

DRILLER or DIGGER

ADDITIONAL DATA:

Log Water Level Measurements Chemical Analysis Aquifer Test

REMARKS: