

STATE ENGINEER
Salem, Oregon

LANE
7459

Well Record

STATE WELL NO. 16/3W-29N
COUNTY Lane
APPLICATION NO. GR-3458

OWNER: James Lake


MAILING ADDRESS: Route 2, Box 402

LOCATION OF WELL: Owner's No. Well #2

CITY AND STATE: Eugene, Oregon

SW 1/4 SW 1/4 Sec. 29 T. 16 N. 3 E. S., R. W., W.M.

Bearing and distance from section or subdivision corner N. 460' W. 230'

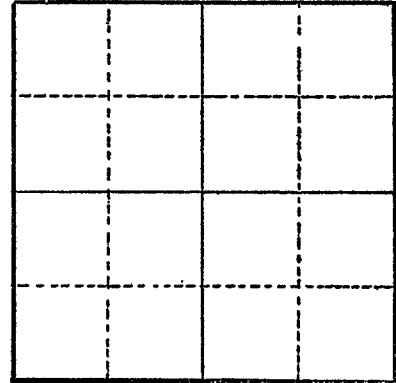

Section

Altitude at well

TYPE OF WELL: driven Date Constructed 1948

Depth drilled 20' Depth cased

CASING RECORD:

FINISH:

driving point (perferated) (3) from 0 to 24

AQUIFERS:

WATER LEVEL:

14'

PUMPING EQUIPMENT: Type Wisconsin H.P. 30
Capacity 360 G.P.M.

WELL TESTS:

Drawdown ft. after hours G.P.M.
Drawdown ft. after hours G.P.M.

USE OF WATER Irrigation Temp. °F., 19

SOURCE OF INFORMATION GR-3199

DRILLER or DIGGER

ADDITIONAL DATA:

Log Water Level Measurements Chemical Analysis Aquifer Test

REMARKS: