

STATE ENGINEER
Salem, Oregon

LANE
7476

Well Record

GR-931

STATE WELL NO. 16/3W-30F(1)
COUNTY Lane
APPLICATION NO. GR-960

OWNER: C. A. Stallings

MAILING
ADDRESS: Rt. 2, Box 470A


LOCATION OF WELL: Owner's No.

CITY AND
STATE: Eugene, Oregon

SE $\frac{1}{4}$ NW $\frac{1}{4}$ Sec. 30 T. 16 S. R. 3 W., W.M.

Bearing and distance from section or subdivision

corner 660' N45°W of the Center of Sec. 30.

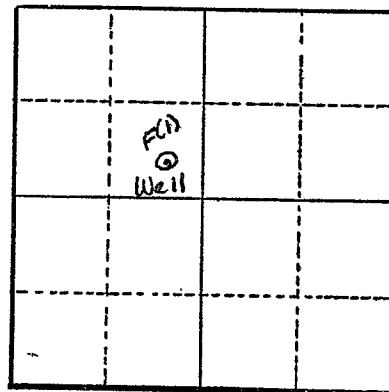

Altitude at well 369 ft.

TYPE OF WELL: Dug Date Constructed 1941

Depth drilled 10 ft. Depth cased

Section 30

CASING RECORD:

60 inch

FINISH:

AQUIFERS:

WATER LEVEL:

9 ft.

PUMPING EQUIPMENT: Type Centrifugal H.P. 10
Capacity 300 G.P.M.

WELL TESTS:

Drawdown 3 ft. after 500 hours G.P.M.

Drawdown ft. after hours G.P.M.

USE OF WATER Irrigation Temp. °F. 19

SOURCE OF INFORMATION G.R. Record

DRILLER or DIGGER

ADDITIONAL DATA:

Log Water Level Measurements Chemical Analysis Aquifer Test

REMARKS:

Log: Newberg silt loam
Sandy loam
Gravel

0 to 4 ft.
4 to 8 $\frac{1}{2}$ ft.
8 $\frac{1}{2}$ to 10 ft.

Irrigation of 17 acres.