

LANE
7477

Well Record

STATE WELL NO. 16/3W-30J
COUNTY Lane
APPLICATION NO. GR-2975

OWNER: Gilbert Simmons


MAILING ADDRESS: Route 2, Box 400

LOCATION OF WELL: Owner's No.

CITY AND STATE: Eugene, Oregon

NE 1/4 SE 1/4 Sec. 30 T. 16 S. R. 3 W., W.M.

Bearing and distance from section or subdivision corner 1480' N. and 510' W. of SE Corner 30, being within Ferguson Land Claim 57

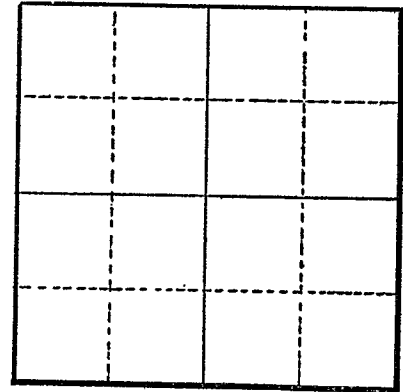

Section

Altitude at well

TYPE OF WELL: Dug & filled Date Constructed 1935

Depth drilled 12 feet Depth cased 12 feet

CASING RECORD:

5-inch

FINISH:

Perforations from 10 to 12

AQUIFERS:

WATER LEVEL:

6 feet

PUMPING EQUIPMENT: Type Variable Capacity 280 G.P.M.

H.P. 10

WELL TESTS:

Drawdown 3 ft. after hours Pumping 280 G.P.M.

Drawdown ft. after hours G.P.M.

USE OF WATER Irrigation Temp. °F. 19

SOURCE OF INFORMATION GR-2896

DRILLER or DIGGER

ADDITIONAL DATA:

Log Water Level Measurements Chemical Analysis Aquifer Test

REMARKS: