

STATE ENGINEER
Salem, Oregon

LANE
7484

Well Record

GR- 1002

STATE WELL NO. 16/3W-30K
COUNTY Lane
APPLICATION NO. GR- 1039

OWNER: Stephen Kenneth Coburn


MAILING ADDRESS: Rt. 2, Box 396

LOCATION OF WELL: Owner's No.

CITY AND STATE: Eugene, Oregon

NW 1/4 SE 1/4 Sec. 30 T. 16 S., R. 3 W., W.M.

Bearing and distance from section or subdivision corner 800' E. & 550' S. of Center of Sec. 30.

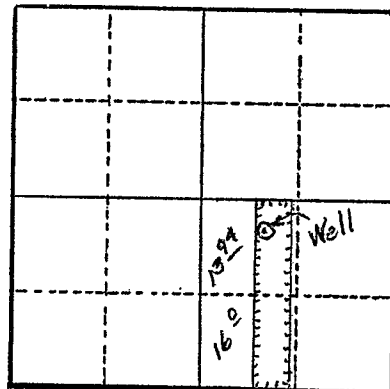

Section 30

Altitude at well 368 ft.

TYPE OF WELL: Dug Date Constructed 1930

Depth drilled 10 ft. Depth cased 10 ft.

CASING RECORD:

24 inch concrete

FINISH:

AQUIFERS:

WATER LEVEL:

6 ft.

PUMPING EQUIPMENT: Type Gorman Rupp 2" Cent. H.P. 10
Capacity 280 G.P.M.

WELL TESTS:

Drawdown 2 ft. after 300 hours G.P.M.

Drawdown ft. after hours G.P.M.

USE OF WATER Irrigation Temp. °F. 19

SOURCE OF INFORMATION G.R. Record

DRILLER or DIGGER

ADDITIONAL DATA:

Log N.A. Water Level Measurements Chemical Analysis Aquifer Test

REMARKS:

Irrigation of 29.94 acres.