

STATE ENGINEER
Salem, Oregon

LANE
7485

Well Record

GR- 1279

STATE WELL NO. 16/3W-30L
COUNTY Lane
APPLICATION NO. GR- 1324

OWNER: John F. Jones

MAILING
ADDRESS:

Rt. 2, Box 394

LOCATION OF WELL: Owner's No. #2


CITY AND
STATE:

Eugene, Oregon

NE 1/4 SW 1/4 Sec. 30 T. 16 N. S., R. 3 W., W.M.

Bearing and distance from section or subdivision

corner 2445' N. & 800' W. from S 1/4 cor. Sec. 30.

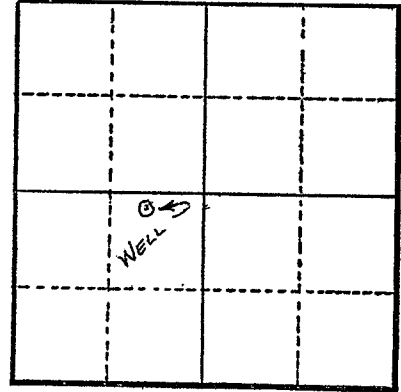

Section 30

Altitude at well 350

TYPE OF WELL: Drilled Date Constructed 1954

Depth drilled 20 ft. Depth cased 20 ft.

CASING RECORD:

4 inch

FINISH:

Blowed from 17 to 20 ft.

AQUIFERS:

WATER LEVEL:

6 ft.

PUMPING EQUIPMENT: Type Berkeley Cent. 3 1/2 in. H.P. 20
Capacity 480 G.P.M.

WELL TESTS:

Drawdown ft. after hours G.P.M.

Drawdown ft. after hours G.P.M.

USE OF WATER Irrigation Temp. °F. 19

SOURCE OF INFORMATION G. R. Record

DRILLER or DIGGER Ramsey - Waite

ADDITIONAL DATA:

Log N.A. Water Level Measurements Chemical Analysis Aquifer Test

REMARKS:

Irrigation of 30.1 acres.