

LANE
7486

Well Record

OWNER: Vernon S. Johnson

MAILING ADDRESS:

LOCATION OF WELL: Owner's No. 1


CITY AND STATE: Eugene, Oregon

..SW...¼ ..SE...¼ Sec.30.. T. ...16... S., R. ...3... W., W.M.

Bearing and distance from section or subdivision

corner 20.50 chs. W. of SE cor. Mounterville

Ferguson & wife DIC

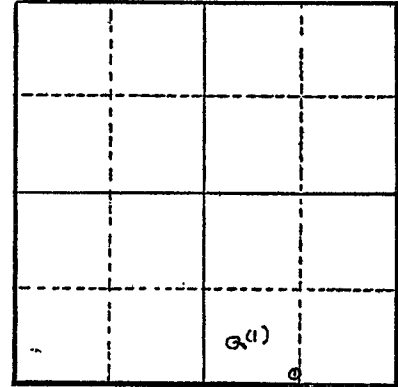

Section 30

Altitude at well 380

TYPE OF WELL: dug Date Constructed 1936

Depth drilled 18 ft. Depth cased

CASING RECORD:

FINISH:

AQUIFERS:

WATER LEVEL: 11

PUMPING EQUIPMENT: Type Berkley 2½" H.P. 15
Capacity 250 G.P.M.

WELL TESTS:

Drawdown 2 ft. after hours 220 G.P.M.

Drawdown 7 ft. after hours 270 G.P.M.

USE OF WATER irrigation Temp. °F., 19

SOURCE OF INFORMATION

DRILLER or DIGGER

ADDITIONAL DATA:

Log N.A. Water Level Measurements Chemical Analysis Aquifer Test

REMARKS: Dug well