

LANE
7518

Well Record

OWNER: Arthur McPherson


MAILING ADDRESS: Rt. 2, Box 391 A

LOCATION OF WELL: Owner's No.

CITY AND STATE: Eugene, Oregon

NW 1/4 NE 1/4 Sec. 31 T. 16 S., R. 3 W., W.M.

Bearing and distance from section or subdivision corner 625 ft. SE 45° of 1/4 corner of North Line of Sec. 31, T. 16 S., R. 3 W.

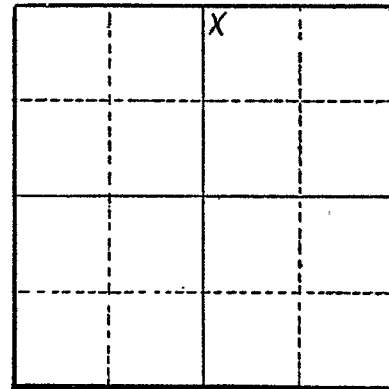

Section 31

Altitude at well

TYPE OF WELL: Drilled Date Constructed 6/2/47

Depth drilled 20 ft. Depth cased

CASING RECORD:

FINISH:

AQUIFERS:

WATER LEVEL:

PUMPING EQUIPMENT: Type Berkeley K.C. 3150 rpm electric motor H.P. 2
Capacity 50 G.P.M.

WELL TESTS:

Drawdown ft. after hours G.P.M.
Drawdown ft. after hours G.P.M.

USE OF WATER Irrigation Temp. °F., 19

SOURCE OF INFORMATION Well Registration Statement

DRILLER or DIGGER

ADDITIONAL DATA:

Log Water Level Measurements Chemical Analysis Aquifer Test

REMARKS: