

**LANE**  
7521


# Well Record

OWNER: Pansy Miller & Claude Miller Mailing ADDRESS: Rt. 2, Box 389

LOCATION OF WELL: Owner's No. CITY AND STATE: Eugene, Oregon

SE 1/4 NW 1/4 Sec. 31 T. 16 N. S, R. 3 W., W.M.

Bearing and distance from section or subdivision corner N. 120' W. 7'

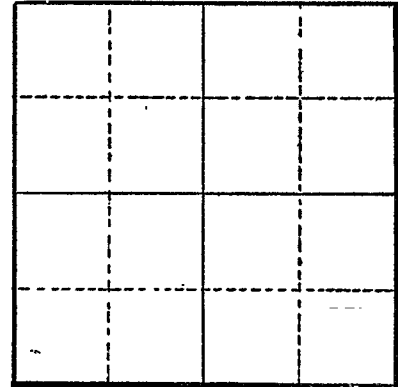

Section

Altitude at well

TYPE OF WELL: Driven Date Constructed 1951

Depth drilled 20 Depth cased

CASING RECORD:

FINISH:

AQUIFERS:

WATER LEVEL:

14-feet

PUMPING EQUIPMENT: Type Sears Roebuck Centrifugal H.P. 3  
Capacity 120 G.P.M.

WELL TESTS:

Drawdown ft. after hours G.P.M.

Drawdown ft. after hours G.P.M.

USE OF WATER Irrigation Temp. °F., 19

SOURCE OF INFORMATION GR-2387

DRILLER or DIGGER

ADDITIONAL DATA:

Log Water Level Measurements Chemical Analysis Aquifer Test

REMARKS: