

STATE ENGINEER
Salem, Oregon

LANE
7522

Well Record

STATE WELL NO. 16/3W-31F
COUNTY LANE
~~APPLICATION NO. GR-2317~~

OWNER: George V. Knox


MAILING ADDRESS: Rt. 2, Box 389-A

LOCATION OF WELL: Owner's No. _____

CITY AND STATE: Eugene, Oregon

SE 1/4 NW 1/4 Sec. 31 T. 16 S., R. 3 W., W.M.

Bearing and distance from section or subdivision
corner 2140' S. and 1150' W.

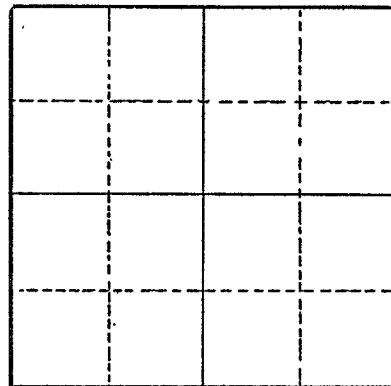

Section _____

Altitude at well _____

TYPE OF WELL: Driven Date Constructed 1948

Depth drilled 20 Depth cased 20

CASING RECORD:

3-inch

FINISH:

1/2" x 1" slots - 50 per foot from 17 to 20

AQUIFERS:

WATER LEVEL:

14-feet

PUMPING EQUIPMENT: Type Berkeley Centrifugal 2 1/2 x 3 H.P. 15
Capacity 280 G.P.M.

WELL TESTS:

Drawdown 1 ft. after _____ hours Pumping 600 G.P.M.

Drawdown _____ ft. after _____ hours _____ G.P.M.

USE OF WATER Irrigation Temp. _____ °F., 19 _____

SOURCE OF INFORMATION GR-2207

DRILLER or DIGGER _____

ADDITIONAL DATA:

Log _____ Water Level Measurements _____ Chemical Analysis _____ Aquifer Test _____

REMARKS: