

LANE  
7524

# Well Record

OWNER: Herman Howard

MAILING

ADDRESS: Rt. 2, Box 387

LOCATION OF WELL: Owner's No.


CITY AND

STATE: Eugene, Oregon

SE 1/4 NE 1/4 Sec. 31 T. 16 S., R. 3 W., W.M.

Bearing and distance from section or subdivision

corner 600' N. & 900' W. from E<sup>1</sup> cor. Sec. 31

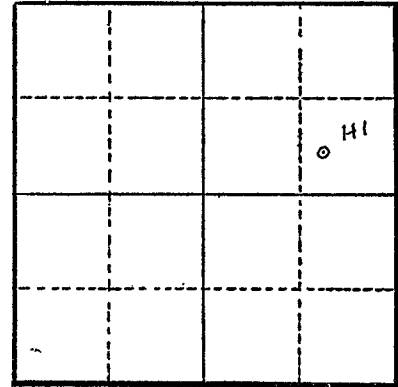

Section 31

Altitude at well 380

TYPE OF WELL: driven Date Constructed Spring 43

Depth drilled 20 Depth cased 20

CASING RECORD: 3 - 2" pipes

FINISH:

AQUIFERS:

WATER LEVEL: 12 ft.

PUMPING EQUIPMENT: Type Pacific centrifugal H.P. 10  
Capacity 400 G.P.M.

WELL TESTS:

Drawdown ft. after hours G.P.M.

Drawdown ft. after hours G.P.M.

USE OF WATER irrigation 19 acres Temp. °F., 19

SOURCE OF INFORMATION GR-383

DRILLER or DIGGER

ADDITIONAL DATA:

Log <sup>X</sup> Water Level Measurements Chemical Analysis Aquifer Test

REMARKS: Log: Top soil 0 - 4 ft.  
River gravel 4 - 20 ft.