

STATE ENGINEER  
Salem, Oregon

LANE  
7526

# Well Record

GR- 1304

STATE WELL NO. 16/3W-31H(3)  
COUNTY Lane  
APPLICATION NO. GR- 1348

OWNER: Io Sidwell


MAILING ADDRESS: Rt. 2, Box 384

LOCATION OF WELL: Owner's No.

CITY AND STATE: Eugene, Oregon

SE 1/4 NE 1/4 Sec. 31 T. 16 N. S., R. 3 W., W.M.

Bearing and distance from section or subdivision corner 2600' S. & 720' E. from NE cor. Sec. 31.

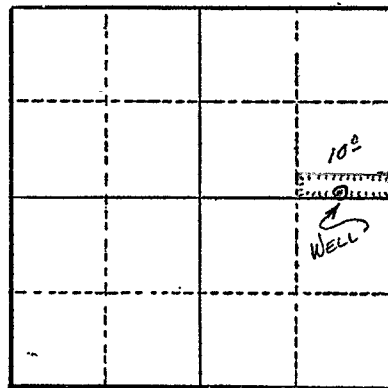

Section 31

Altitude at well 375 ft.

TYPE OF WELL: Dug Date Constructed 1930

Depth drilled 9 ft. Depth cased 9 ft.

### CASING RECORD:

3 x 3 ft. concrete

### FINISH:

Perforated: 4 per ft. about 2 1/2 in. in diameter from 6 to 9 ft.

### AQUIFERS:

### WATER LEVEL:

6 ft.

PUMPING EQUIPMENT: Type F. M. 1 1/4 x 1 1/2 in. Cent. H.P. 5  
Capacity 90 G.P.M.

### WELL TESTS:

Drawdown	1	ft. after	hours	200	G.P.M.
Drawdown	1.5	ft. after	hours	500	G.P.M.

USE OF WATER Irrigation Temp. °F. 19

SOURCE OF INFORMATION G. R. Record

DRILLER or DIGGER

### ADDITIONAL DATA:

Log Water Level Measurements Chemical Analysis Aquifer Test

### REMARKS:

Log: Newberg silty clay loam & sandy loam	0 to 3 ft.
Unconsolidated gravels - water bearing	3 to 8 ft.
Blue clay	8 to 9 ft.

Irrigation of 10 acres.