


Well Record

GR- 1606

OWNER: Carmen Edith Reynolds MAILING ADDRESS: Rt. 2, Box 382

LOCATION OF WELL: Owner's No. _____ CITY AND STATE: Eugene, Oregon

NE 1/4 SE 1/4 Sec. 31 T. 16 S., R. 3 W., W.M.
Bearing and distance from section or subdivision
corner 1320' S. & 340' W. from E 1/4 cor. Sec. 31

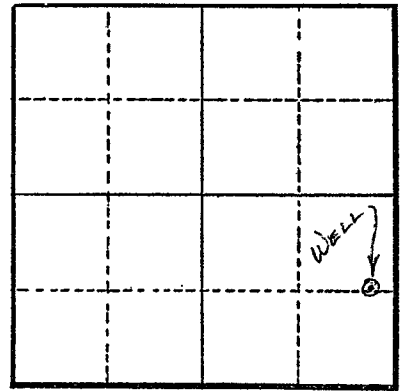

Section 31

Altitude at well 375'

TYPE OF WELL: Driven Date Constructed 1938

Depth drilled 21' Depth cased 21'

CASING RECORD:

4 - 1 1/2" pipes

FINISH:

Perforated: 22 holes 3/8" per ft. from 18 to 22 ft.

AQUIFERS:

WATER LEVEL:

10 to 12 ft.

PUMPING EQUIPMENT: Type F. M. 3" x 2" Cent. H.P. 10
Capacity 300 G.P.M.

WELL TESTS:

Drawdown _____ ft. after _____ hours _____ G.P.M.
Drawdown _____ ft. after _____ hours _____ G.P.M.

USE OF WATER Irrigation Temp. _____ °F. _____, 19____

SOURCE OF INFORMATION GR Record

DRILLER or DIGGER _____

ADDITIONAL DATA:

Log N.A. Water Level Measurements _____ Chemical Analysis _____ Aquifer Test _____

REMARKS:

Irrigation of 14 acres.