

STATE ENGINEER  
Salem, Oregon

LANE  
7534

# Well Record

STATE WELL NO. 16/3W-31R  
COUNTY LANE  
APPLICATION NO. GR-2920

OWNER: Leon Smith

MAILING ADDRESS:

Rt. 2, Box 387 A

LOCATION OF WELL: Owner's No.


CITY AND STATE:

Eugene, Oregon

NW SE 31 16-N. 3-E.  
1/4 1/4 Sec. T. S., R. W., W.M.

Bearing and distance from section or subdivision

corner 1830' N. 1650' W.

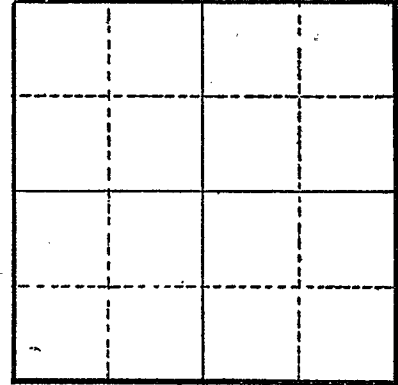

Section

Altitude at well

TYPE OF WELL: driven Date Constructed 1940

Depth drilled 20 Depth cased 20

### CASING RECORD:

2-inch

### FINISH:

3/8" holes drilled about 6 from 17' to 20'

### AQUIFERS:

WATER LEVEL:  
10-feet

PUMPING EQUIPMENT: Type Berkeley Centrifugal H.P. 15  
Capacity 250 G.P.M.

### WELL TESTS:

Drawdown ft. after hours G.P.M.  
Drawdown ft. after hours G.P.M.

USE OF WATER Irrigation Temp. °F., 19

SOURCE OF INFORMATION GR-2750

DRILLER or DIGGER

### ADDITIONAL DATA:

Log Water Level Measurements Chemical Analysis Aquifer Test

### REMARKS: