

STATE ENGINEER  
Salem, Oregon

LANE  
7537

# Well Record

STATE WELL NO. 16/3W-31K(1)  
COUNTY Lane  
APPLICATION NO. GR-1122

GR- 1082

OWNER: Elmer Johnson

MAILING  
ADDRESS:

LOCATION OF WELL: Owner's No.


CITY AND  
STATE:

Coburg, Oregon

NW 1/4 SE 1/4 Sec. 31 T. 16 S., R. 3 W., W.M.

Bearing and distance from section or subdivision

corner 2295.4' W. & 231.5' N. of NW cor. DIC #59.

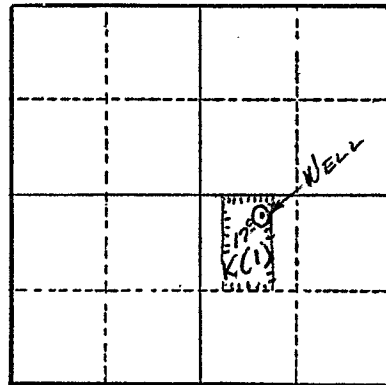

Section 31

Altitude at well 375 ft.

TYPE OF WELL: Driven Date Constructed 1950

Depth drilled 20 ft. Depth cased 20 ft.

### CASING RECORD:

3 - 2 1/2 inch

### FINISH:

### AQUIFERS:

### WATER LEVEL:

PUMPING EQUIPMENT: Type 2" Cent. - A.C. Gas motor H.P.  
Capacity G.P.M.

### WELL TESTS:

Drawdown ft. after hours G.P.M.

Drawdown ft. after hours G.P.M.

USE OF WATER Irrigation Temp. °F., 19

SOURCE OF INFORMATION G. R. Record

DRILLER or DIGGER

### ADDITIONAL DATA:

Log N. A. Water Level Measurements Chemical Analysis Aquifer Test

### REMARKS:

Irrigation of 17 acres.