

OWNER: John Nelson Whitaker

MAILING ADDRESS:

LOCATION OF WELL: Owner's No. 1


CITY AND STATE: Coburg, Oregon

NW 1/4 NE 1/4 Sec. 32 T. 16 S., R. 3 W., W.M.

Bearing and distance from section or subdivision

corner 556 ft. S. 59° 52' W. from SW cor.

Issac Van Duyn DLG

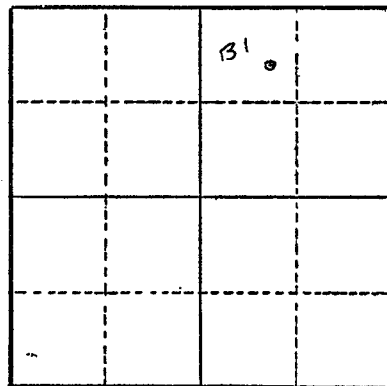

Altitude at well 350 ft. Interpolated

TYPE OF WELL: Dug Date Constructed 1929

Depth drilled 10.5 ft. Depth cased 10.5 ft.

Section 32

CASING RECORD: 48 in. steel tubing from 0 to 10.5 ft.

FINISH:

AQUIFERS:

WATER LEVEL: 4 feet

PUMPING EQUIPMENT: Type 3 phase elec. - F.M. 3x2 in. H.P. 10
Capacity 250 G.P.M.

WELL TESTS:

Drawdown 4 ft. after 500 hours G.P.M.

Drawdown ft. after hours G.P.M.

USE OF WATER irrigation Temp. °F., 19

SOURCE OF INFORMATION GR-776

DRILLER or DIGGER

ADDITIONAL DATA:

Log Water Level Measurements Chemical Analysis Aquifer Test

REMARKS:

