

STATE ENGINEER
Salem, Oregon

LANE
7562

Well Record

STATE WELL NO. 16/3W-32C(1)
COUNTY Lane
APPLICATION NO. GR-777

OWNER: John Nelson Whitaker


MAILING ADDRESS:

LOCATION OF WELL: Owner's No. 2

CITY AND STATE: Coburg, Oregon

NE 1/4 NW 1/4 Sec. 32 T. 16 S., R. 3 W., W.M.

Bearing and distance from section or subdivision corner 1482 ft. S. 81° 53' W. from SW cor. of Issac Van Duyne DLC

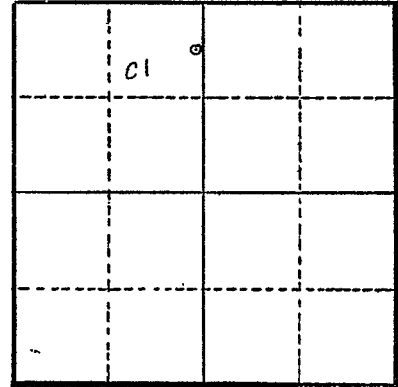

Section 32

Altitude at well 385 ft. Interpolated

TYPE OF WELL: Dug Date Constructed 1933

Depth drilled 4 ft. Depth cased none

CASING RECORD: none

FINISH:

AQUIFERS:

WATER LEVEL: 2 ft.

PUMPING EQUIPMENT: Type 3 phase elec. - F.M. 3x2 in. H.P. 10
Capacity 250 G.P.M.

WELL TESTS:

Drawdown 1 ft. after 500 hours G.P.M.

Drawdown ft. after hours G.P.M.

USE OF WATER irrigation Temp. °F., 19

SOURCE OF INFORMATION GR-777

DRILLER or DIGGER

ADDITIONAL DATA:

Log Water Level Measurements Chemical Analysis Aquifer Test

REMARKS:

