

STATE ENGINEER
Salem, Oregon

LANE
7565

Well Record

STATE WELL NO. 16/3W-32H
COUNTY LANE
~~APPLICATION NO.~~ GR-2526

OWNER: A. C. Zinser

MAILING ADDRESS: Box 77


LOCATION OF WELL: Owner's No. #2

CITY AND STATE: Coburg, Oregon

SE 1/4 NE 1/4 Sec. 32 T. 16 N S, R. 3 E W., W.M.

Bearing and distance from section or subdivision

corner S. 1460' W. 980'

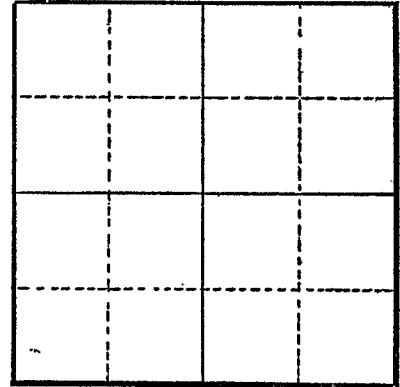

Section

Altitude at well

TYPE OF WELL: Driven Date Constructed 1944

Depth drilled 30 Depth cased

CASING RECORD:

FINISH:

AQUIFERS:

WATER LEVEL:

12-feet

PUMPING EQUIPMENT: Type Fairbanks Morse Centrifugal H.P. 10
Capacity 200 G.P.M.

WELL TESTS:

Drawdown ft. after hours G.P.M.

Drawdown ft. after hours G.P.M.

USE OF WATER Irrigation Temp. °F., 19

SOURCE OF INFORMATION GR-2389

DRILLER or DIGGER

ADDITIONAL DATA:

Log Water Level Measurements Chemical Analysis Aquifer Test

REMARKS: