

STATE ENGINEER
Salem, Oregon

LANE
7566

Well Record

STATE WELL NO. 16/3W-32H(1)
COUNTY Lane
APPLICATION NO. GR-954

GR-925

OWNER: Clay Whitaker


MAILING ADDRESS: Rt. 2, Box 359

LOCATION OF WELL: Owner's No. #1

CITY AND STATE: Eugene, Oregon

SE 1/4 NE 1/4 Sec. 32 T. 16 S., R. 3 W., W.M.

Bearing and distance from section or subdivision corner S9°3'E, 1718' from the SW cor. of the Issac VanDuyne DLC.

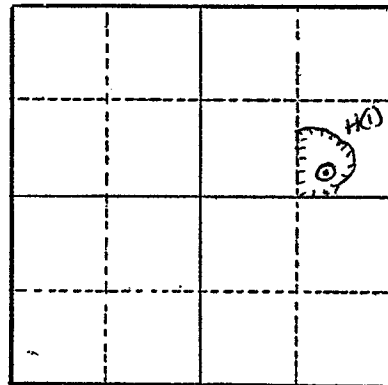

Section 32

Altitude at well 385 ft.

TYPE OF WELL: Driven Date Constructed 1940

Depth drilled 18 ft. Depth cased 18 ft.

CASING RECORD:

4 inch

FINISH:

1/2 x 3 inch slits from 14 to 18 ft.

AQUIFERS:

WATER LEVEL:

12 ft.

PUMPING EQUIPMENT: Type 2 x 2 1/2 inch Centrifugal H.P. 10
Capacity 200 G.P.M.

WELL TESTS:

Drawdown 4 ft. after hours 200 G.P.M.

Drawdown ft. after hours G.P.M.

USE OF WATER Irrigation Temp. °F., 19

SOURCE OF INFORMATION G.R. Record

DRILLER or DIGGER

ADDITIONAL DATA:

Log Water Level Measurements Chemical Analysis Aquifer Test

REMARKS:

Log: Sandy loam 0 to 4 ft.
Medium sized gravel 4 to 18 ft.

Irrigation of 18 acres.