

STATE ENGINEER
Salem, Oregon

LANE
7567

Well Record

GR-926

STATE WELL NO. 16/3W-32H(2)
COUNTY Lane
APPLICATION NO. GR-955

OWNER: Clay Whitaker

MAILING

ADDRESS: Rt. 2, Box 359

LOCATION OF WELL: Owner's No. #2

CITY AND


STATE: Eugene, Oregon

SE 1/4 NE 1/4 Sec. 32 T. 16 S., R. 3 W., W.M.

Bearing and distance from section or subdivision

corner S1°36'W. 823' from the SW cor. of the

Issac Van Dyne DIC.

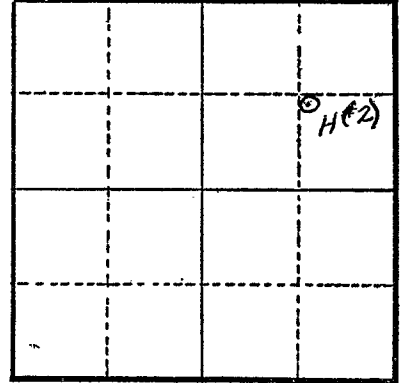

Section 32

Altitude at well 380 ft.

TYPE OF WELL: Driven Date Constructed 1932

Depth drilled 12 ft. Depth cased 12 ft.

CASING RECORD:

2 1/2 inch (3 hole connected in series)

FINISH:

1/2 inch holes bored 2 inches apart from 8 to 12 ft.

AQUIFERS:

WATER LEVEL:

2 ft.

PUMPING EQUIPMENT: Type 2 inch Centrifugal H.P. 7 1/2
Capacity 150 G.P.M.

WELL TESTS:

Drawdown 6 ft. after 150 hours G.P.M.

Drawdown ft. after hours G.P.M.

USE OF WATER Irrigation Temp. °F. 19

SOURCE OF INFORMATION G.R. Record

DRILLER or DIGGER

ADDITIONAL DATA:

Log Water Level Measurements Chemical Analysis Aquifer Test

REMARKS:

Log: Medium sized gravel 0 to 12 ft.

Irrigation of 6 acres.