

STATE ENGINEER
Salem, Oregon

LANE
7571

Well Record

STATE WELL NO. 16/3W-32J
COUNTY LANE
APPLICATION NO. GR-2342

OWNER: C. W. Pitkin


MAILING ADDRESS: Rt. 2, Box 344 A

LOCATION OF WELL: Owner's No. #1

CITY AND STATE: Eugene, Oregon

NE 1/4 SE 1/4 Sec. 32 T. 16S N. S., R. 3 W., W.M.

Bearing and distance from section or subdivision corner N. 51° E 1900'

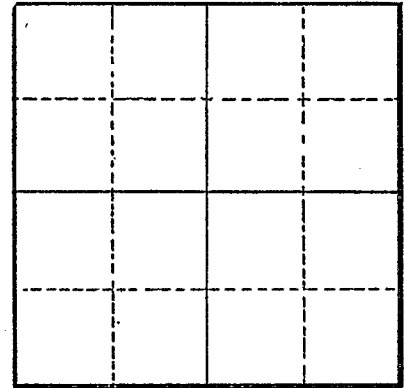

Section

Altitude at well

TYPE OF WELL: Dug Date Constructed 1935

Depth drilled 16 Depth cased

CASING RECORD:

FINISH:

AQUIFERS:

WATER LEVEL:

8-feet

PUMPING EQUIPMENT: Type Allis Chalmers Centrifugal H.P. 15
Capacity 300 G.P.M.

WELL TESTS:

Drawdown ft. after hours G.P.M.
Drawdown ft. after hours G.P.M.

USE OF WATER Irrigation Temp. °F., 19

SOURCE OF INFORMATION GR-2226

DRILLER or DIGGER

ADDITIONAL DATA:

Log Water Level Measurements Chemical Analysis Aquifer Test

REMARKS: