

STATE ENGINEER  
Salem, Oregon

LANE  
7580

# Well Record

GR- 1531

STATE WELL NO. 16/3W-32M  
COUNTY Lane  
APPLICATION NO. GR- 1583

OWNER: Clifford R. Bowser


MAILING ADDRESS: Rt. 2, Box 381

LOCATION OF WELL: Owner's No. #1

CITY AND STATE: Eugene, Oregon

NW ¼ SW ¼ Sec. 32 T. 16 S., R. 3 W., W.M.

Bearing and distance from section or subdivision corner S. 490' & E. 250' from W ¼ cor. Sec. 32.

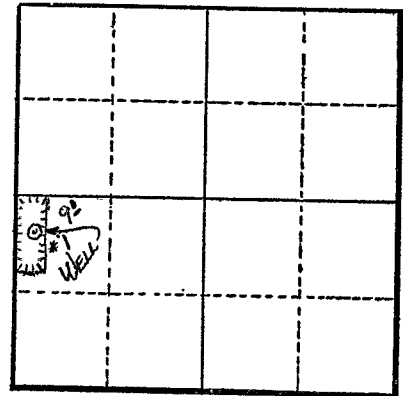

Section 32

Altitude at well 375'

TYPE OF WELL: Driven Date Constructed 1933

Depth drilled 18' Depth cased 18'

### CASING RECORD:

4 - 1 1/4" set about 2' apart.

### FINISH:

Slot perforated from 15 to 18 ft.

### AQUIFERS:

### WATER LEVEL:

12'

PUMPING EQUIPMENT: Type Peerless 1 1/2" x 2" Cent. H.P. 7 1/2  
Capacity 150 G.P.M.

### WELL TESTS:

Drawdown ..... ft. after ..... hours ..... G.P.M.  
Drawdown ..... ft. after ..... hours ..... G.P.M.

USE OF WATER Irrigation Temp. °F. 19

SOURCE OF INFORMATION GR Record

DRILLER or DIGGER

### ADDITIONAL DATA:

Log N.A. Water Level Measurements ..... Chemical Analysis ..... Aquifer Test .....

### REMARKS:

Irrigation of 9 acres.