

STATE ENGINEER
Salem, Oregon

LANE
7581

Well Record

GR- 1317

STATE WELL NO. 16/3W-32M
COUNTY Lane
APPLICATION NO. GR- 1362

OWNER: Fred T. Mendenhall


MAILING ADDRESS: Rt. 2, Box 378

LOCATION OF WELL: Owner's No. #1

CITY AND STATE: Eugene, Oregon

NW 1/4 SW 1/4 Sec. 32 T. 16 S., R. 3 W., W.M.

Bearing and distance from section or subdivision corner 1600' N. & 1350' E. from SW cor. Sec. 32

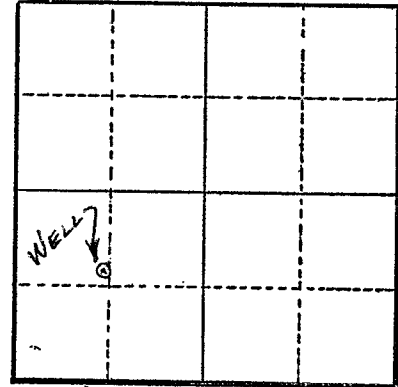

Section 32

Altitude at well 335 ft.

TYPE OF WELL: Driven Date Constructed 1930

Depth drilled 18 ft. Depth cased 18 ft.

CASING RECORD:

3 - 2 in. pipes

FINISH:

Perforated from 14 to 18 ft.

AQUIFERS:

WATER LEVEL:

10 ft.

PUMPING EQUIPMENT: Type Berkeley Cent. H.P. 10
Capacity 250 G.P.M.

WELL TESTS:

Drawdown 0 ft. after 250 hours G.P.M.

Drawdown _____ ft. after _____ hours G.P.M.

USE OF WATER Irrigation Temp. °F. 19

SOURCE OF INFORMATION G. R. Record

DRILLER or DIGGER

ADDITIONAL DATA:

Log _____ Water Level Measurements _____ Chemical Analysis _____ Aquifer Test _____

REMARKS:

Log: Top soil (loam) 0 to 10 ft.
Sand & gravel 10 to 18 ft.

Irrigation of 23 acres.