

STATE ENGINEER
Salem, Oregon

LANE
7587

Well Record

STATE WELL NO. 16/3W-32D
COUNTY LANE
APPLICATION NO. GR-2586

OWNER: Eva M. Knox


MAILING ADDRESS: Rt. 2

LOCATION OF WELL: Owner's No.

CITY AND STATE: Eugene, Oregon

NW 1/4 NW 1/4 Sec. 32 T. 16 N. S., R. 3 W., W.M.

Bearing and distance from section or subdivision corner 1100' E. and 1400' N.

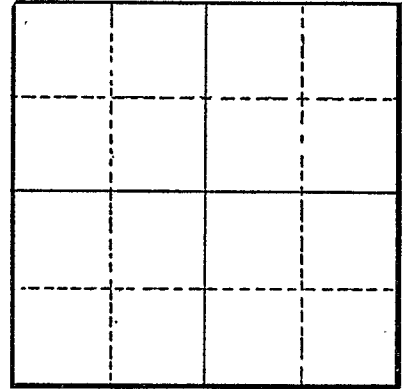

Section

Altitude at well

TYPE OF WELL: Driven Date Constructed 1948

Depth drilled 20 Depth cased 20

CASING RECORD:

3-inch

FINISH:

1/2 x 1" - 50 per foot from 17 to 20

AQUIFERS:

WATER LEVEL:

14-feet

PUMPING EQUIPMENT: Type Berkeley centrifugal H.P. 15
Capacity 280 G.P.M.

WELL TESTS:

Drawdown 1 ft. after hours Pumping 300 G.P.M.
Drawdown ft. after hours G.P.M.

USE OF WATER Irrigation Temp. °F., 19

SOURCE OF INFORMATION GR-2453

DRILLER or DIGGER

ADDITIONAL DATA:

Log Water Level Measurements Chemical Analysis Aquifer Test

REMARKS: