

STATE ENGINEER  
Salem, Oregon

**LANE**  
7590

# Well Record


STATE WELL NO. 16/3W-32E  
COUNTY Lane  
APPLICATION NO. GR-3232

OWNER: Leon H. and/or Flossie Funke  
Smith  
MAILING ADDRESS: Route 2, Box 366

LOCATION OF WELL: Owner's No. Well #3  
CITY AND STATE: Eugene, Oregon

SW 1/4 NW 1/4 Sec. 32 T. 16 N. E. S., R. 3 W., W.M.

Bearing and distance from section or subdivision corner S. 1400'; E. 600' from the N.W. corner of Section 32

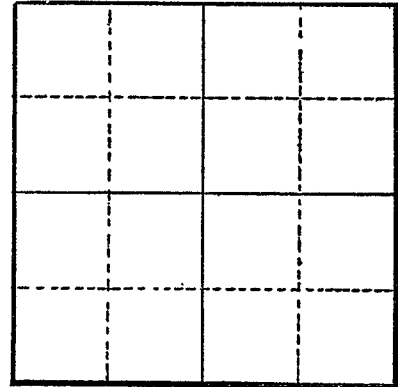

Section .....

Altitude at well .....

TYPE OF WELL: driven Date Constructed 1951

Depth drilled 28 Depth cased .....

### CASING RECORD:

### FINISH:

Slotted 1/8" x 6" about 6 per foot from 24 to 28

### AQUIFERS:

### WATER LEVEL:

12 feet

PUMPING EQUIPMENT: Type Myers, Cent. H.P. 15  
Capacity 360 G.P.M.

### WELL TESTS:

Drawdown ..... ft. after ..... hours ..... G.P.M.

Drawdown ..... ft. after ..... hours ..... G.P.M.

USE OF WATER Irrigation Temp. °F. ...., 19

SOURCE OF INFORMATION GR-3009

DRILLER or DIGGER .....

### ADDITIONAL DATA:

Log ..... Water Level Measurements ..... Chemical Analysis ..... Aquifer Test .....

### REMARKS: