

STATE ENGINEER
Salem, Oregon

LANE
7591

Well Record

STATE WELL NO. 16/3W-32E
COUNTY Lane
APPLICATION NO. GR-3231


OWNER: Leon H. and/or Flossie Funke
Smith

MAILING ADDRESS: Route 2, Box 366

LOCATION OF WELL: Owner's No. Well #2
CITY AND STATE: Eugene, Oregon

SW 1/4 SW 1/4 Sec. 32 T. 16 N. E. S., R. 3 W., W.M.

Bearing and distance from section or subdivision corner S. 2000'; E. 880' from N.W. corner of Section 32

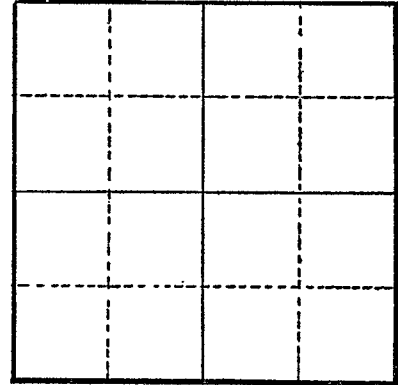

Section

Altitude at well

TYPE OF WELL: dug Date Constructed 1940

Depth drilled 20 Depth cased 20

CASING RECORD:

36 inch

FINISH:

AQUIFERS:

WATER LEVEL:
10 feet

PUMPING EQUIPMENT: Type Bingham Cent. H.P.
Capacity 260 G.P.M.

WELL TESTS:

Drawdown ft. after hours G.P.M.
Drawdown ft. after hours G.P.M.

USE OF WATER Irrigation Temp. °F., 19

SOURCE OF INFORMATION GR-3008

DRILLER or DIGGER William Hills (deceased)

ADDITIONAL DATA:

Log Water Level Measurements Chemical Analysis Aquifer Test

REMARKS: