

STATE ENGINEER
Salem, Oregon

LANE
7592

Well Record

STATE WELL NO. 16/3W-32E(1)
COUNTY Lane
APPLICATION NO. GR-1231

GR- 1190

OWNER: Kate D. Sidwell

MAILING
ADDRESS:

Rt. 2, Box 364

LOCATION OF WELL: Owner's No.


CITY AND
STATE:

Eugene, Oregon

SW 1/4 NW 1/4 Sec. 32 T. 16 ^{XIV} S., R. 3 ^{EX} W., W.M.

Bearing and distance from section or subdivision

corner 2440' S. & 1430' E. from NW cor. Sec. 32.

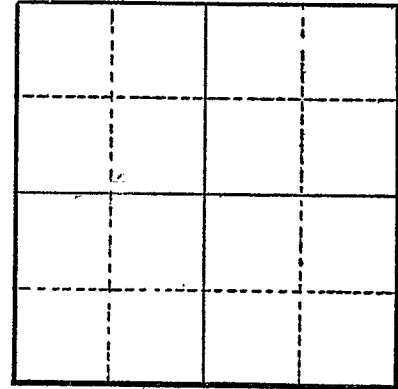

Section 32

Altitude at well 385 ft.

TYPE OF WELL: Dug Date Constructed 1929

Depth drilled 16 ft. Depth cased 16 ft.

CASING RECORD:

36 in. reinforced concrete

FINISH:

AQUIFERS:

WATER LEVEL:

12 ft.

PUMPING EQUIPMENT: Type F. M. 2 x 3 in. Cent. H.P. 10
Capacity 206 G.P.M.

WELL TESTS:

Drawdown 2 ft. after 200 hours G.P.M.

Drawdown ft. after hours G.P.M.

USE OF WATER Irrigation Temp. °F. 19

SOURCE OF INFORMATION G. R. Record

DRILLER or DIGGER

ADDITIONAL DATA:

Log Water Level Measurements Chemical Analysis Aquifer Test

REMARKS:

Log; Chehalis - Newberg soils 0 to 6 ft.
Unconsolidated gravels(water) 6 to 15 ft.
Cement gravel 15 to 16 ft.

Irrigation of 24 acres.