

STATE ENGINEER  
Salem, Oregon

LANE  
7594

# Well Record


STATE WELL NO. 16/3W-32G  
COUNTY Lane  
APPLICATION NO. GR-1225

OWNER: V. F. VanDawark  
MAILING ADDRESS: Route 2, Box 362

LOCATION OF WELL: Owner's No. \_\_\_\_\_  
CITY AND STATE: Eugene, Oregon

SW 1/4 NE 1/4 Sec. 32 T. 16 N. S., R. 3 W., W.M.

Bearing and distance from section or subdivision  
corner 200' E. & 1150' N. of Sec. 32

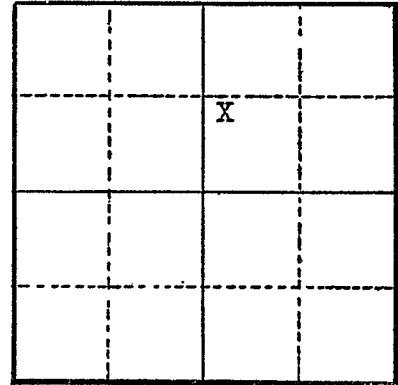

Section 32

Altitude at well \_\_\_\_\_

TYPE OF WELL: Driven Date Constructed 1926

Depth drilled 12 ft. Depth cased \_\_\_\_\_

### CASING RECORD:

### FINISH:

### AQUIFERS:

### WATER LEVEL:

6 feet below surface

PUMPING EQUIPMENT: Type Berkeley H.P. 15  
Capacity 400 G.P.M.

### WELL TESTS:

Drawdown \_\_\_\_\_ ft. after \_\_\_\_\_ hours \_\_\_\_\_ G.P.M.

Drawdown \_\_\_\_\_ ft. after \_\_\_\_\_ hours \_\_\_\_\_ G.P.M.

USE OF WATER Irrigation Temp. \_\_\_\_\_ °F., 19

SOURCE OF INFORMATION Well Registration Statement Cert. # GR-3788

DRILLER or DIGGER \_\_\_\_\_

### ADDITIONAL DATA:

Log \_\_\_\_\_ Water Level Measurements \_\_\_\_\_ Chemical Analysis \_\_\_\_\_ Aquifer Test \_\_\_\_\_

### REMARKS: