

STATE ENGINEER
Salem, Oregon

LANE
7597

Well Record

GR- 1191

STATE WELL NO. 16/(3W-32G)2)
COUNTY Lane
APPLICATION NO. GR- 1232

OWNER: Kate D. Sidwell


MAILING ADDRESS: Rt. 2, Box 364

LOCATION OF WELL: Owner's No.

CITY AND STATE: Eugene, Oregon

SW 1/4 NE 1/4 Sec. 32 T. 16 S, R. 3 W., W.M.

Bearing and distance from section or subdivision corner 2340' S. & 2820' E. from NW cor. Sec. 32.

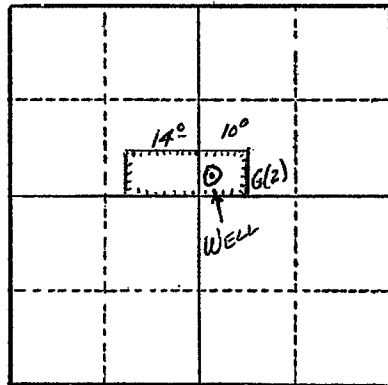

Altitude at well 385 ft.

TYPE OF WELL: Dug Date Constructed 1929

Depth drilled 20 ft. Depth cased 20 ft.

Section 32

CASING RECORD:

24 in. reinforced concrete

FINISH:

AQUIFERS:

WATER LEVEL:

10 ft.

PUMPING EQUIPMENT: Type F. M. 1 1/2 x 2 in. Cent. H.P. 7 1/2
Capacity 140 + G.P.M.

WELL TESTS:

Drawdown 1 ft. after 160 hours G.P.M.

Drawdown ft. after hours G.P.M.

USE OF WATER Irrigation Temp. °F. 19

SOURCE OF INFORMATION G. R. Record

DRILLER or DIGGER

ADDITIONAL DATA:

Log Water Level Measurements Chemical Analysis Aquifer Test

REMARKS:

Log: Chehalis & Newberg soils	0 to 6 ft.
Unconsolidated gravels (water)	6 to 18 ft.
Cement gravel	18 to 20 ft.

Irrigation of 24 acres.