

STATE ENGINEER  
Salem, Oregon

**LANE**  
7599

# Well Record

STATE WELL NO. 16/3W-32K(3)  
COUNTY Lane  
APPLICATION NO. GR-3224

OWNER: Leon H. and/or Flossie Funke


MAILING ADDRESS: Route 2, Box 366

LOCATION OF WELL: Owner's No. 2

CITY AND STATE: Eugene, Oregon

NW 1/4 SE 1/4 Sec. 32 T. 16 S., R. 3 W., W.M.

Bearing and distance from section or subdivision corner 1580' N. and 500' W. from the S.W. corner of the SE<sup>1</sup>/<sub>4</sub> SE<sup>1</sup>/<sub>4</sub> of Section 32

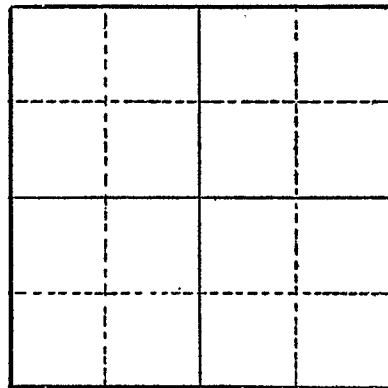

Section 21

Altitude at well \_\_\_\_\_

TYPE OF WELL: drove Date Constructed 1948

Depth drilled 21 Depth cased 21

### CASING RECORD:

4 inch

### FINISH:

Slotted 1/8" x 6" 6 per foot from 17 to 21

### AQUIFERS:

### WATER LEVEL:

4 feet

PUMPING EQUIPMENT: Type Allis Chalmer Cent. H.P. 15  
Capacity 360 G.P.M.

### WELL TESTS:

Drawdown \_\_\_\_\_ ft. after \_\_\_\_\_ hours \_\_\_\_\_ G.P.M.  
Drawdown \_\_\_\_\_ ft. after \_\_\_\_\_ hours \_\_\_\_\_ G.P.M.

USE OF WATER Irrigation Temp. \_\_\_\_\_ °F. \_\_\_\_\_, 19\_\_\_\_

SOURCE OF INFORMATION GR-3001

DRILLER or DIGGER Owner

### ADDITIONAL DATA:

Log \_\_\_\_\_ Water Level Measurements \_\_\_\_\_ Chemical Analysis \_\_\_\_\_ Aquifer Test \_\_\_\_\_

### REMARKS: