

LANE
7602

Well Record

OWNER: Leon H. and/or Flossie Funke


MAILING ADDRESS: Route 2, Box 366

LOCATION OF WELL: Owner's No.

CITY AND STATE: Eugene, Oregon

NE 1/4 SW 1/4 Sec. 32 T. 16, S., R. 3 W., W.M.

Bearing and distance from section or subdivision corner
1780' N. and 1900' W. from the S.W. corner of the SE 1/4 SE 1/4 of Section 32

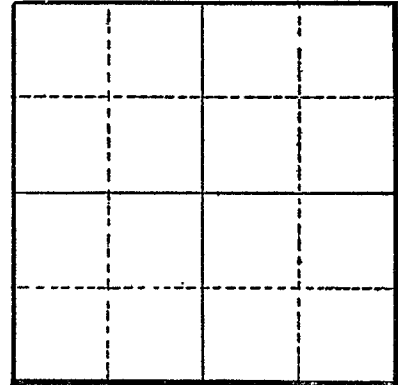

Section

Altitude at well

TYPE OF WELL: drove Date Constructed 1938

Depth drilled 21 Depth cased 21

CASING RECORD:

3 (2") inch from 0 to 21

FINISH:

Holes 1/8" 16 per foot from 17 1/2 to 21

AQUIFERS:

WATER LEVEL:

12 feet

PUMPING EQUIPMENT: Type Allis Chalmers Cent. H.P. 15
Capacity 360 G.P.M.

WELL TESTS:

Drawdown ft. after hours G.P.M.
Drawdown ft. after hours G.P.M.

USE OF WATER Irrigation Temp. °F., 19

SOURCE OF INFORMATION GR-3003

DRILLER or DIGGER Owner

ADDITIONAL DATA:

Log Water Level Measurements Chemical Analysis Aquifer Test

REMARKS: