


OWNER: Leon H. and/or Flossie Funke MAILING ADDRESS: Route 2, Box 366

LOCATION OF WELL: Owner's No. 3 CITY AND STATE: Eugene, Oregon

NE 1/4 SW 1/4 Sec. 32 T. 16 N. S., R. 3 E. W., W.M.

Bearing and distance from section or subdivision corner 1680' N. and 1400' W. from the SW Corner of the SE 1/2 SE 1/2 of Section 32

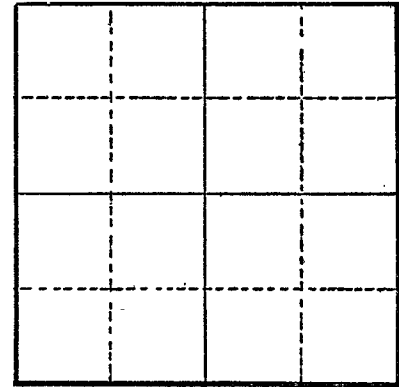

Section

Altitude at well

TYPE OF WELL: drove Date Constructed 1938

Depth drilled 21' Depth cased 21'

CASING RECORD:

5 (2) inch

FINISH:

Holes 1/2" 12 per foot from 17 1/2 to 21

AQUIFERS:

WATER LEVEL:

12'

PUMPING EQUIPMENT: Type Fairbanks Morse Cent. H.P. 10  
Capacity 260 G.P.M.

WELL TESTS:

Drawdown ft. after hours G.P.M.  
Drawdown ft. after hours G.P.M.

USE OF WATER Irrigation Temp. °F. 19

SOURCE OF INFORMATION GR-3002

DRILLER or DIGGER Owner

ADDITIONAL DATA:

Log Water Level Measurements Chemical Analysis Aquifer Test

REMARKS: