

STATE ENGINEER  
Salem, Oregon

LANE  
7620

# Well Record


STATE WELL NO. 16/3W-32K(1)  
COUNTY Lane  
APPLICATION NO. GR-3227

OWNER: Leon H. and/or Flossie Funke Mailing ADDRESS: Route 2, Box 366

LOCATION OF WELL: Owner's No. Distillery well CITY AND STATE: Eugene, Oregon

NW 1/4 SE 1/4 Sec. 32 T. 16 S., R. 3 W., W.M.

Bearing and distance from section or subdivision corner N. 1865'; W. 500' from the S.E. corner of the SW 1/4 SE 1/4 of Section 32

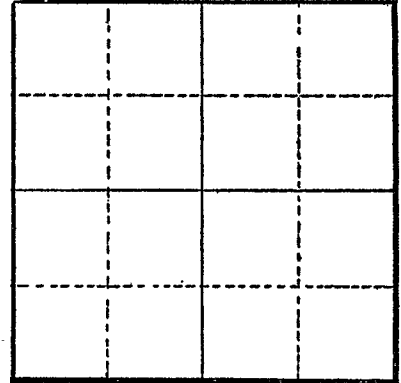

Section

Altitude at well

TYPE OF WELL: driven Date Constructed 1928

Depth drilled 21 Depth cased

### CASING RECORD:

### FINISH:

Holes 1/8" 16 per foot from 17 1/2 to 21

### AQUIFERS:

### WATER LEVEL:

12 feet

PUMPING EQUIPMENT: Type 1 Fairbanks Morse, 1hp: 1 Fairbanks Morse 3/4 H.P. hp: and Capacity 35 G.P.M. ( 3 pumps hooked together ) 1 Myers, 3/4 hp.

### WELL TESTS:

Drawdown ft. after hours G.P.M.  
Drawdown ft. after hours G.P.M.

USE OF WATER Distillery Temp. °F., 19

SOURCE OF INFORMATION GR-3004

DRILLER or DIGGER

### ADDITIONAL DATA:

Log Water Level Measurements Chemical Analysis Aquifer Test

### REMARKS: