

**LANE**  
7621


# Well Record

OWNER: Leon H. and/or Flossie Funke MAILING ADDRESS: Route 2, Box 366

LOCATION OF WELL: Owner's No. \_\_\_\_\_ CITY AND STATE: Eugene, Oregon

NW ¼ SE ¼ Sec. 32 T. 16 S., R. 3 W., W.M.

Bearing and distance from section or subdivision corner 1700' N. and 400' W. from the S.W. corner of the SE¼ SE¼, of Section 32

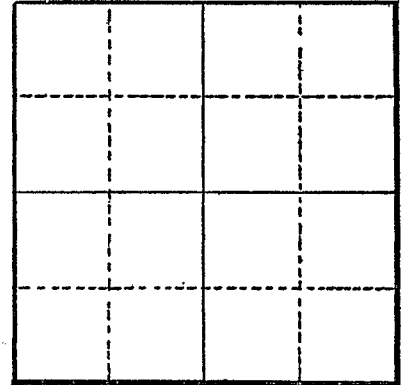

Section \_\_\_\_\_

Altitude at well \_\_\_\_\_

TYPE OF WELL: drive Date Constructed 1938

Depth drilled 16 Depth cased 16

### CASING RECORD:

3 (2") inch

### FINISH:

¼" drilled holes 6 per foot from 12 to 16

### AQUIFERS:

### WATER LEVEL:

PUMPING EQUIPMENT: Type Fairbanks Morse Cent. H.P. 10  
Capacity 260 G.P.M.

### WELL TESTS:

Drawdown \_\_\_\_\_ ft. after \_\_\_\_\_ hours \_\_\_\_\_ G.P.M.  
Drawdown \_\_\_\_\_ ft. after \_\_\_\_\_ hours \_\_\_\_\_ G.P.M.

USE OF WATER Irrigation Temp. \_\_\_\_\_ °F., 19\_\_\_\_

SOURCE OF INFORMATION GR-3000

DRILLER or DIGGER Owner

### ADDITIONAL DATA:

Log \_\_\_\_\_ Water Level Measurements \_\_\_\_\_ Chemical Analysis \_\_\_\_\_ Aquifer Test \_\_\_\_\_

### REMARKS: